


5.1.2 AS-BUILT DRAWINGS

Please note that all drawings below are hyperlinked to the drawings listed in the below register. Please click on the drawing title to go directly to the drawing you wish to view.

Drawing Register: RG+P Ltd

Architectural Finishes Schedule

DRAWING NUMBER	DRAWING TITLE	REV
E21062-RGP-A-00-DR-A-1700	Floor Finishes - Ground Floor Plan A	C01
E21062-RGP-A-01-DR-A-1701	Floor Finishes - First Floor Plan A	C02
E21062-RGP-A-02-DR-A-1702	Floor Finishes - 2nd Floor Plan A	C02
E21062-RGP-A-06-DR-A-1721	Floor Finishes - 6th Floor Plan A	C02
E21062-RGP-A-09-DR-A-1704	Floor Finishes - Ninth Floor Plan A	C03
E21062-RGP-A-SL-DR-A-1703	Floor Finishes - 3rd to 5th Floor Plan A	C03
E21062-RGP-A-SL-DR-A-1722	Floor Finishes - 7th to 8th Floor Plan A	C01
E21062-RGP-B-00-DR-A-2700	Floor Finishes - Ground Floor Plan Block B	C01
E21062-RGP-B-01-DR-A-2701	Floor Finishes - First Floor Plan Block B	C03
E21062-RGP-B-02-DR-A-2702	Floor Finishes - 2nd Floor Plan Block B	C03
E21062-RGP-B-06-DR-A-2715	Floor Finishes - 6th Floor Plan Block B	C01
E21062-RGP-B-07-DR-A-2704	Floor Finishes - Seventh Floor Plan Block B	C03
E21062-RGP-B-SL-DR-A-2703	Floor Finishes - 3rd to 5th Floor Plan Block B	C03
E21062-RGP-C-00-DR-A-3700	Floor Finishes - Ground Floor Plan C	C02
E21062-RGP-C-01-DR-A-3701	Floor Finishes - First Floor Plan C	C02
E21062-RGP-C-02-DR-A-3702	Floor Finishes - Second Floor Plan C	C02
E21062-RGP-D-00-DR-A-4700	Floor Finishes - Ground Floor Plan D	C02
E21062-RGP-D-01-DR-A-4701	Floor Finishes - First Floor Plan D	C02
E21062-RGP-D-SL-DR-A-4702	Floor Finishes - Second-Seventh Floor Plan D	C02
E21062-RGP-E-00-DR-A-5700	Floor Finishes - Ground Floor Plan E	C01
E21062-RGP-E-01-DR-A-5701	Floor Finishes - First Floor Plan E	C02
E21062-RGP-E-SL-DR-A-5702	Floor Finishes - 2nd to 4th Floor Plan E	C02
E21062-RGP-F-00-DR-A-6700	Floor Finishes - Ground Floor Plan F	C03
E21062-RGP-F-01-DR-A-6701	Floor Finishes - First Floor Plan F	C03
E21062-RGP-F-02-DR-A-6702	Floor Finishes - Second Floor Plan F	C03
E21062-RGP-F-03-DR-A-6703	Floor Finishes - Third Floor Plan F	C03

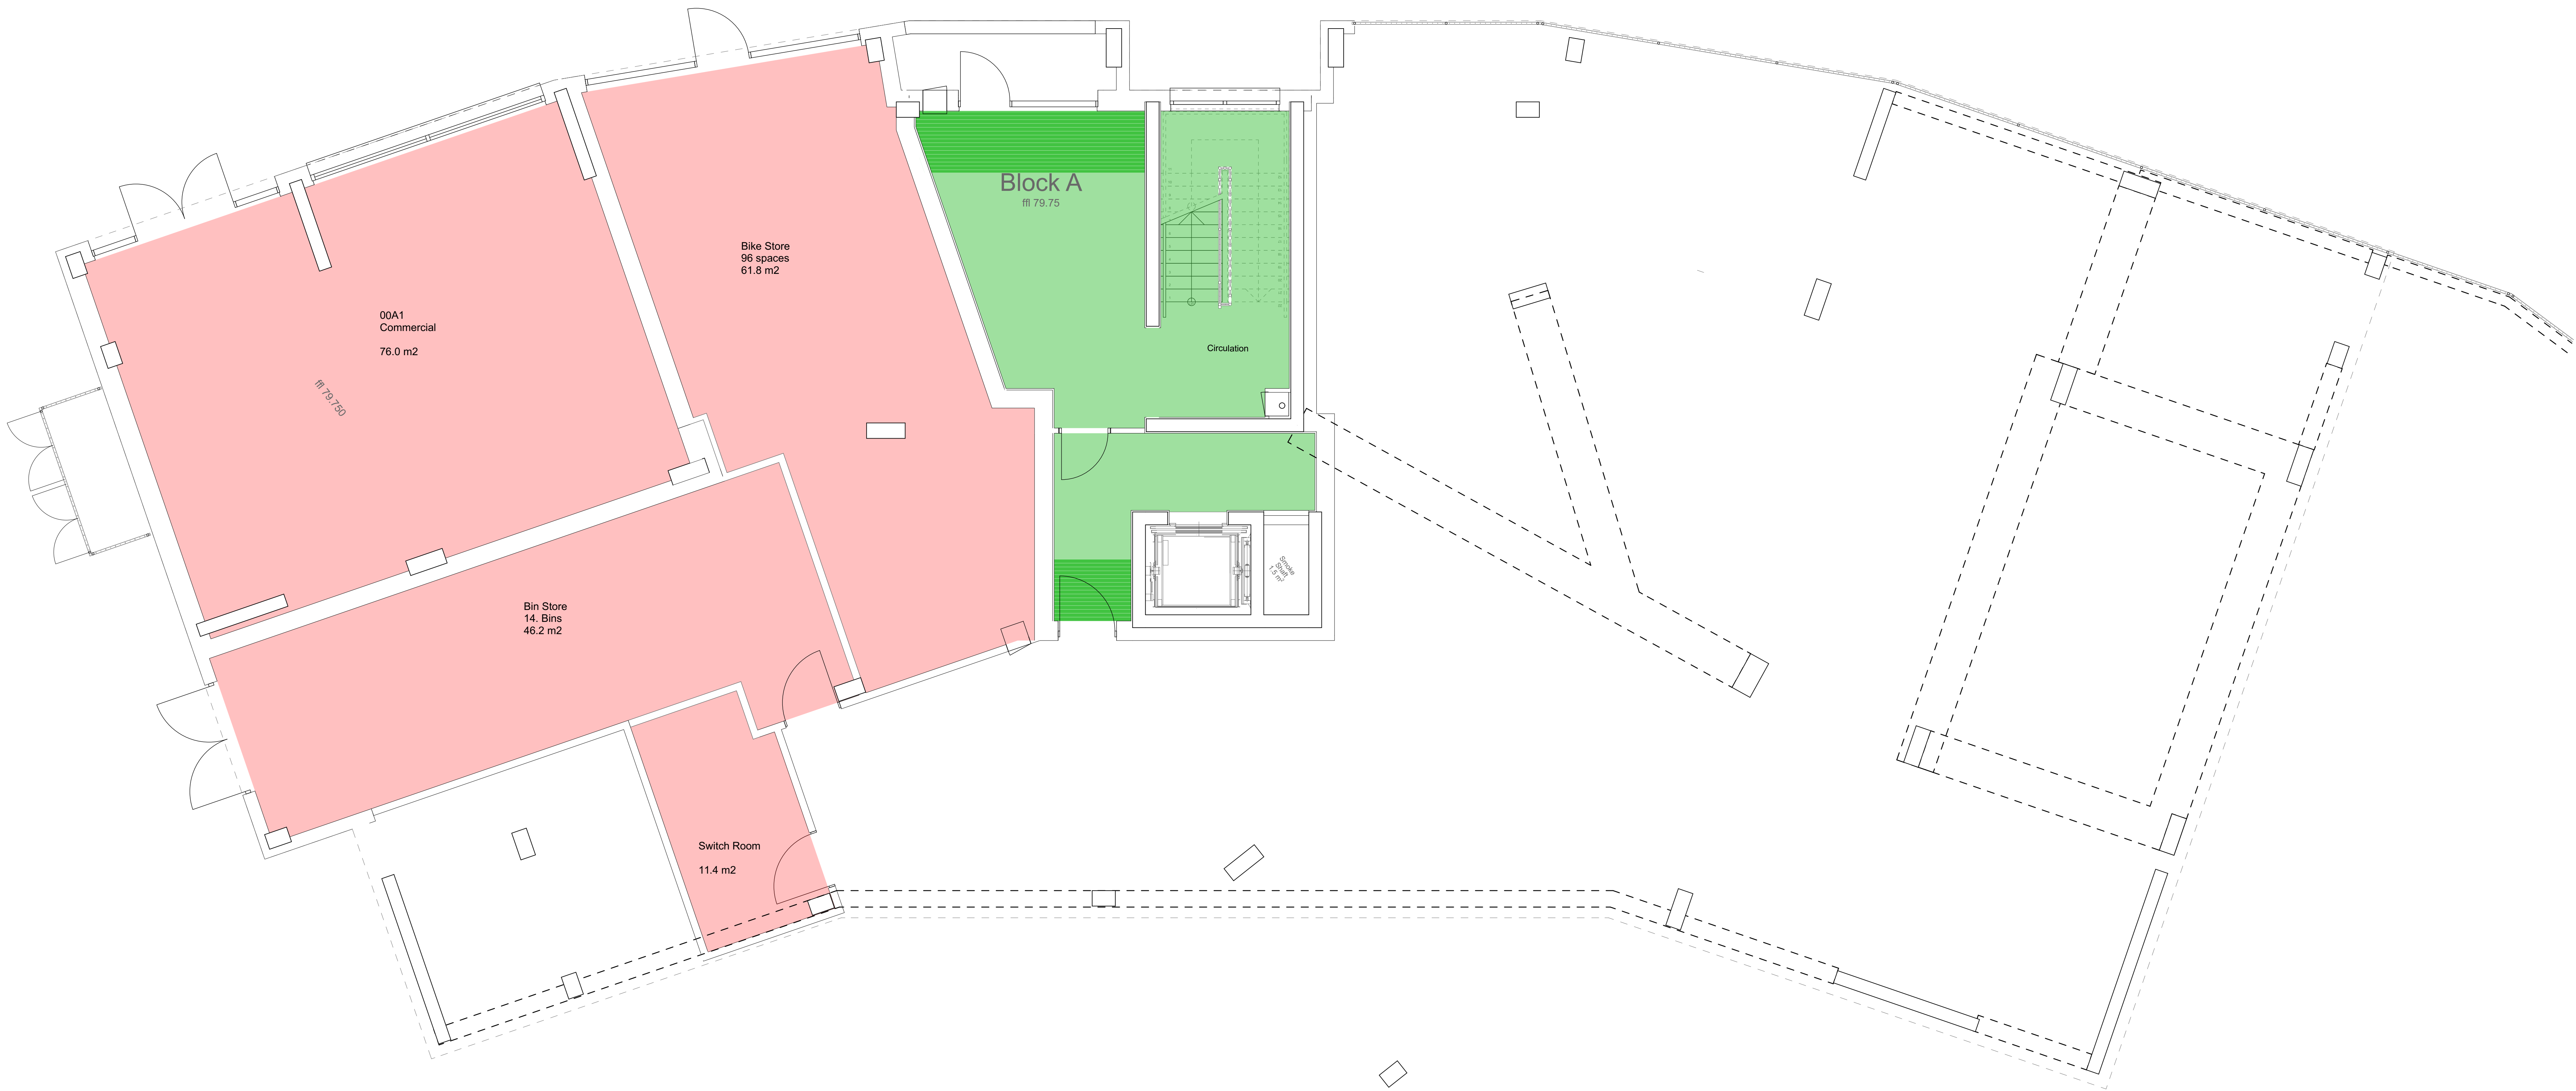


Floor Finish Key	
	Floor - Novosol/Polyfor sheet vinyl
	Floor - Entrance area will be provided with dirt barrier, Gradus Boulevard 1500 or similar type entrance matting, 1.2 m deep, colour from standard range available. Remaining floor areas contrast carpet tiles.
	Floor - Contrast carpet tiles. Manufacturer: CFS Iluxion or CFS VT450, or acceptable equivalent. To staircases provide contrast carpet tiles. Gradus aluminium nosings to all treads in contrasting colour.
	Plant rooms Floor - Watco paint finish



Project:	Bletchley View North 100-331
Status:	CONSTRUCTION
Client:	Winvic Construction Ltd
Sheet title:	Floor finishes - Ground Floor Plan A
Scale:	1:50@A0
Date:	December 2022
Drawn:	LD
Checked:	SD

Ref: E21062-RGP-A-00-DR-A-1700-C01
London | Birmingham | Leicester
0203 327 0981 | 0121 599 0071 | 0116 204 5800
rgp@winvic.co.uk | design@rgp.co.uk

Notes:
All designs should be constructed in strict accordance with building regulations.
In addition any materials, components and fittings to be connected to a supply should be non-combustible (see top sheet of the building above D14).
All dimensions to be checked on site. Do not scale off this drawing for construction purposes.
This drawing is the copyright of the architect, and must be approved and/or their permission.
Ordnance Survey map information reproduced with permission of HMSS. Crown Copyright reserved.
Copyright: Building Design

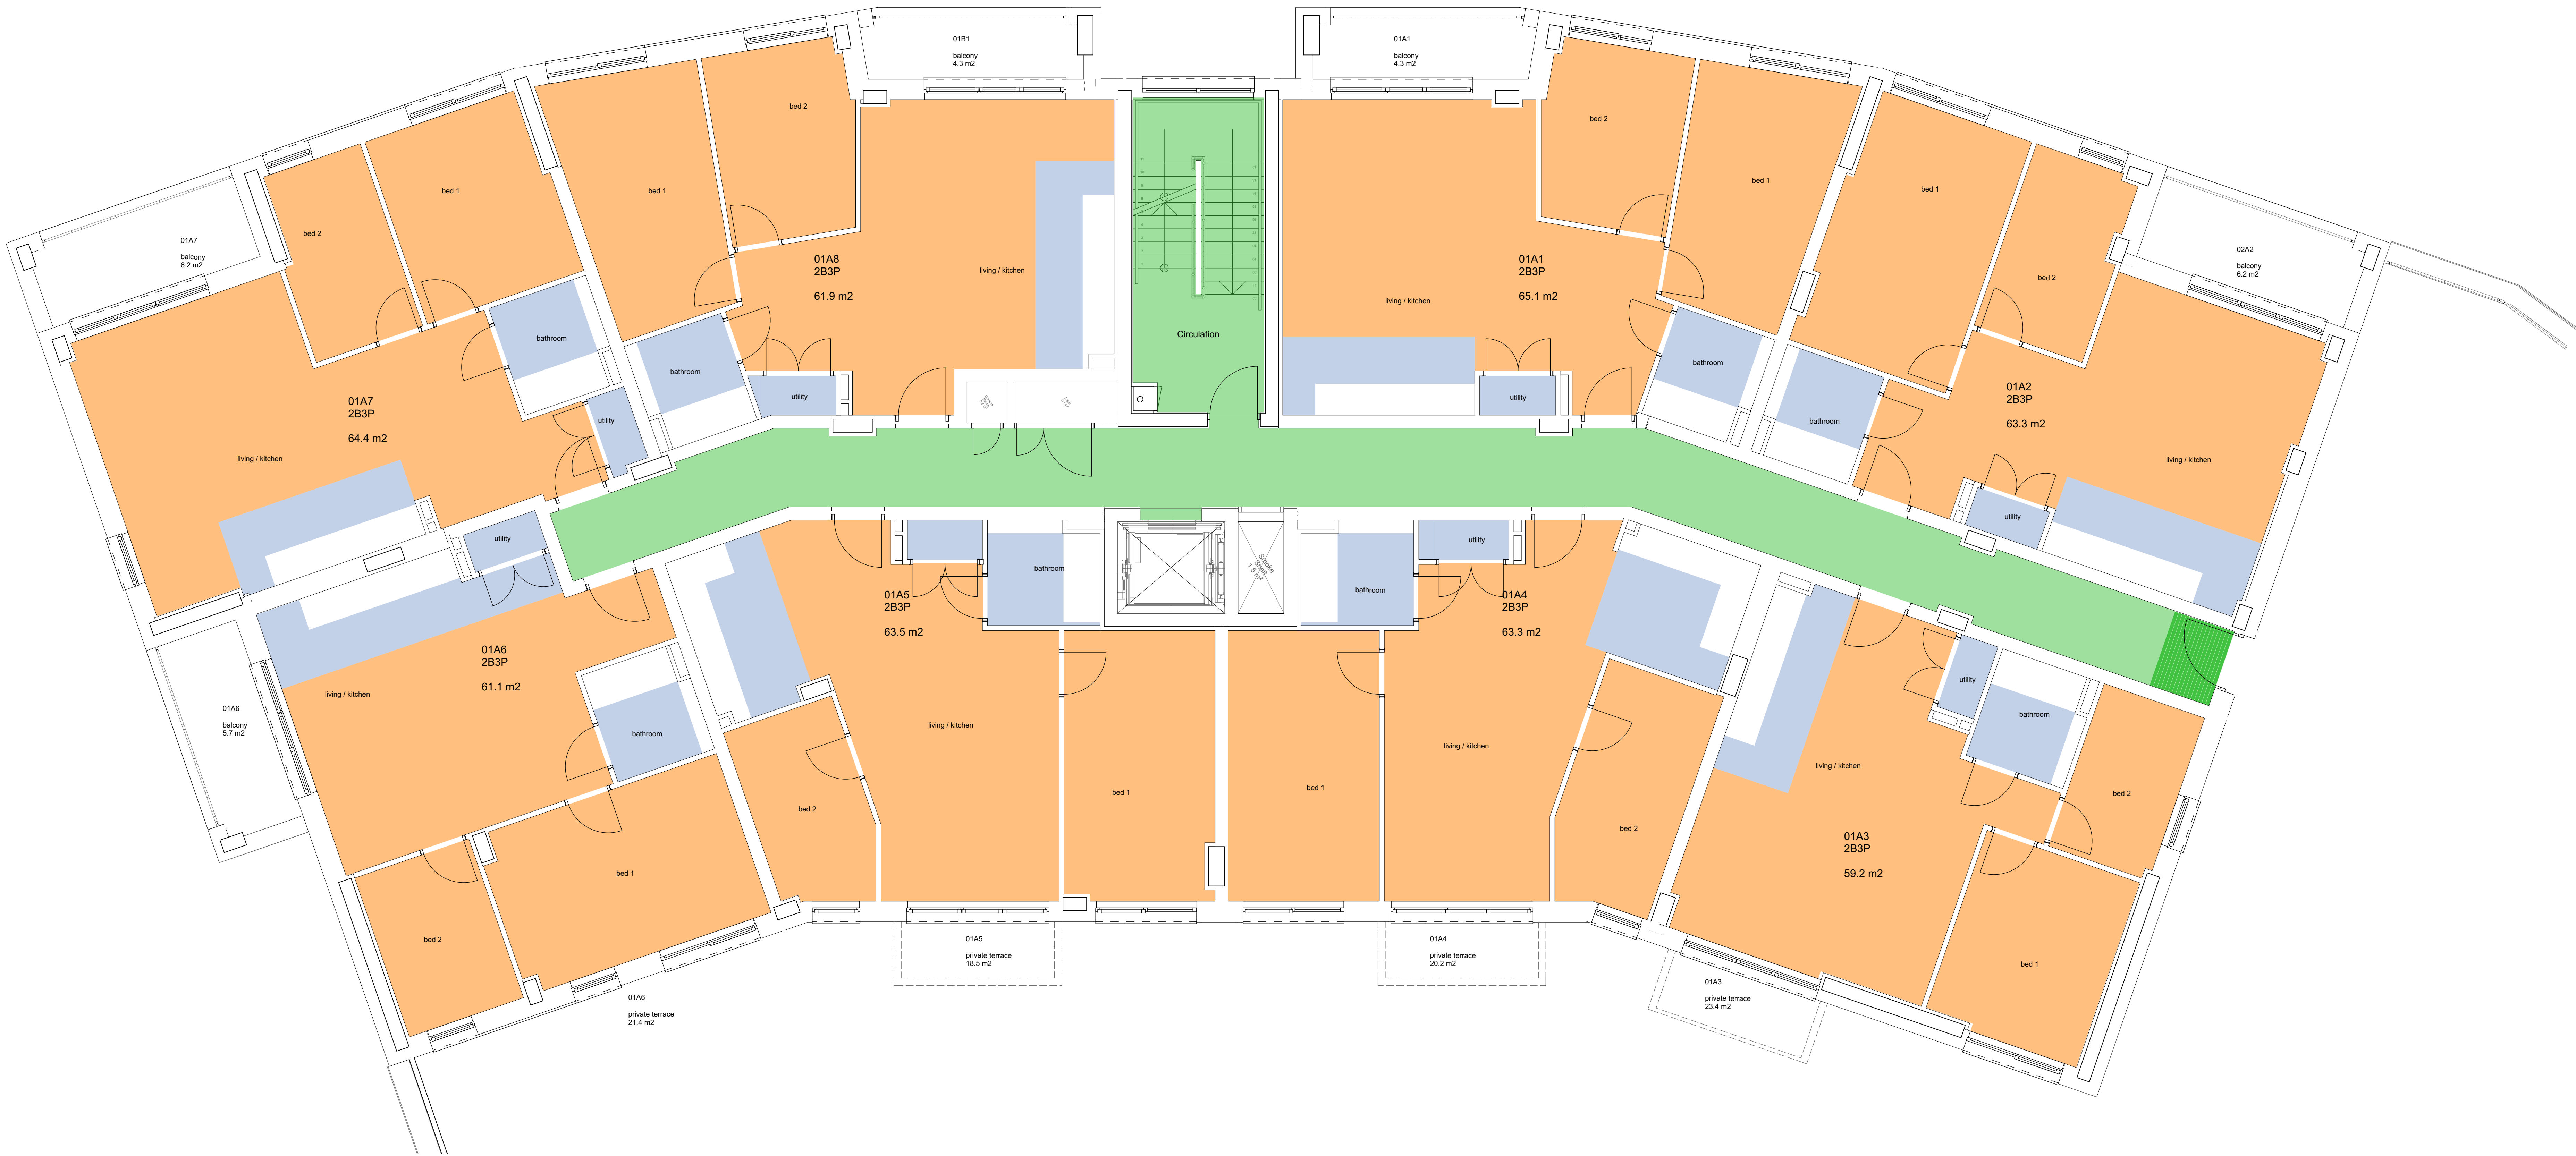

- Floor Finish Key**
- Floor - NeovisonPolyflor sheet vinyl
 - Floor - Entrance areas will be provided with anti-burner, Gracast Boulevard 1500 or similar type entrance matting 1.2 m deep, colour from standard range available. Remaining floor area contract carpet tiles.
 - Floor - Contract carpet tiles. Manufacturer: CFS Ilexion or CFS V1450, or acceptable equivalent. To staircase provide contract carpet tiles. Gracast aluminum nosings to all treads in contrasting colour.
 - Plant rooms Floor - Watco paint non-slip grey finish
 - UNK: Genus carpet



Project: Bleckley View North
100-331

Status: **CONSTRUCTION**

Client: Winvic Construction Ltd

Sheet title: **Floor finishes - First Floor Plan A**

Scale: **1:50@A0**

Date: December 2022


Drawn: LD

Checked: SD

Ref: E21062-RGP-A-01-DR-A-1701-C02

London | Birmingham | Leicester
0203 327 0161 | 0121 599 0071 | 0116 204 5800
rgp@winvic.co.uk | design@rgp.co.uk

Notes:
All drawings should be constructed in strict accordance with building regulations.
In addition any materials, components and fittings not be connected to a supply should be non-combustible (see table of materials in the building rules).
All dimensions to be checked on site. Do not scale off this drawing for construction purposes.
This drawing is the copyright of the architect, and must be reproduced without their permission.
Ordinance Survey map information reproduced with permission of HMDS Crown Copyright reserved.
Copyright: 2022

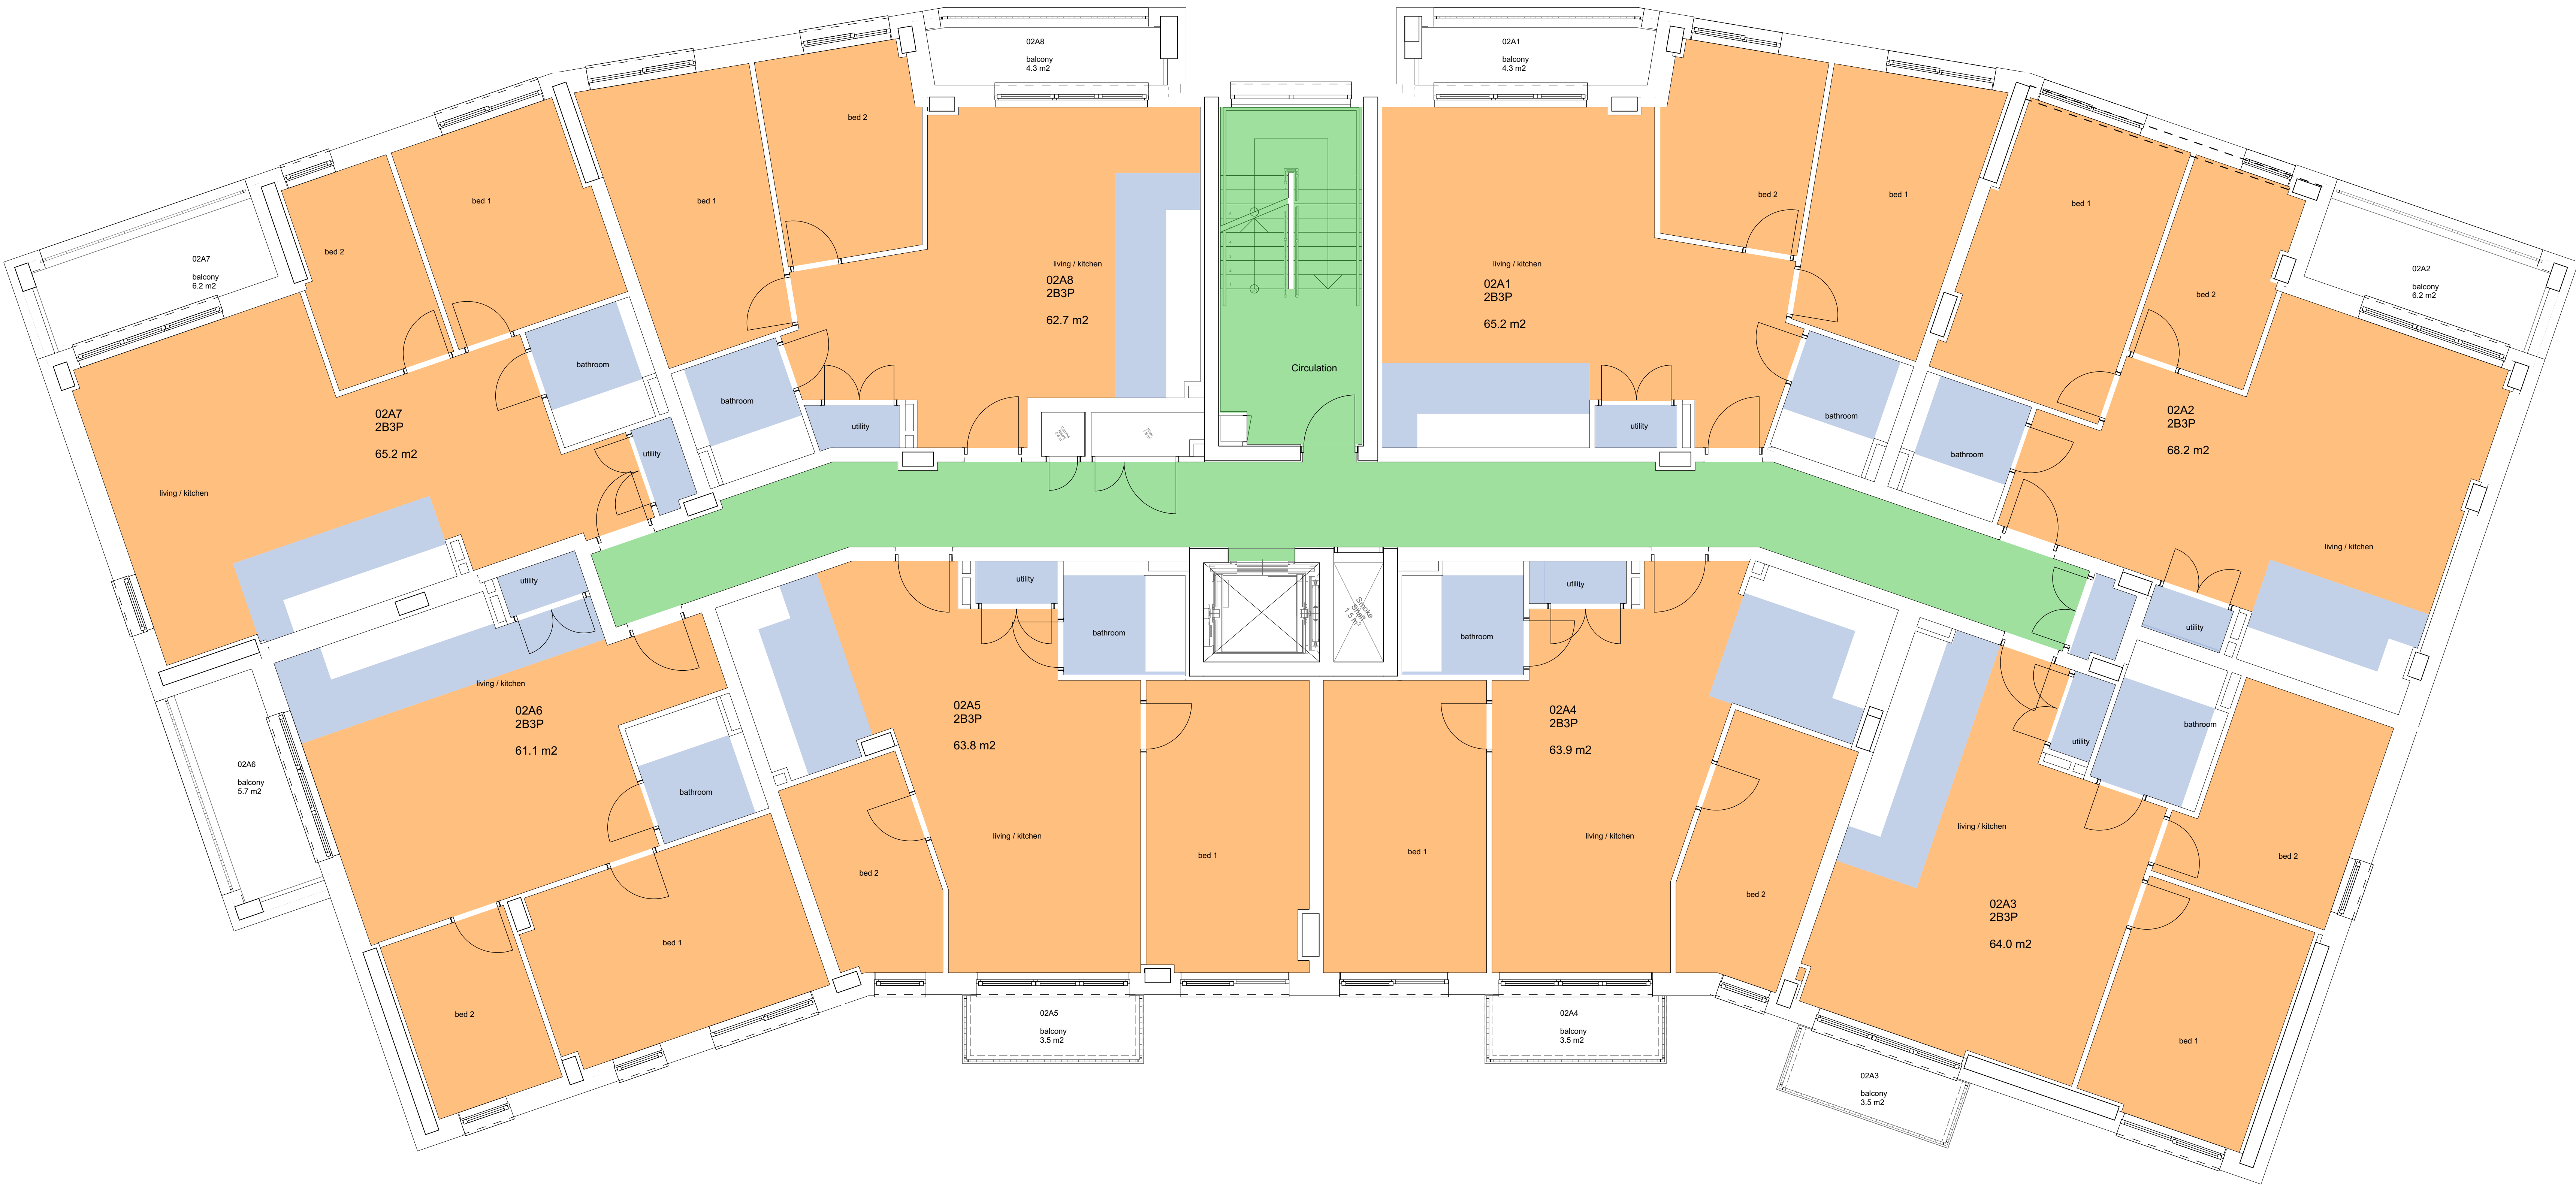

Floor Finish Key	
	Floor - NeovisonPolyflex sheet vinyl
	Floor - Entrance areas will be provided with anti-burner, Gracast Boulevard 1500 or similar type entrance matting 1.2 m deep, colour from standard range available. Remaining floor area contract carpet tiles.
	Floor - Contract carpet tiles. Manufacturer: CFS Ilexion or CFS V1450, or acceptable equivalent. To staircase provide contract carpet tiles. Gracast aluminium nosings to all treads in contrasting colour.
	Plant rooms Floor - Watco paint non-slip grey finish
	UNK: Genus carpet




Project:	Bletchley View North 100-331
Status:	CONSTRUCTION
Client:	Winvic Construction Ltd
Sheet title:	Floor finishes - 2nd Floor Plan A
Scale:	1:50@A0
Date:	December 2022
Drawn:	LD
Checked:	SD


Ref: E21062-RGP-A-02-DR-A-1702-C02

London | Birmingham | Leicester
0203 327 0341 | 0121 599 0071 | 0116 204 5800
rgp@winvic-designbuild.co.uk

Notes:
All designs should be constructed in strict accordance with building regulations.
In addition any materials, components and fittings not be connected to a supply should be non-combustible (the top story of the building above D1).

All dimensions to be checked on site. Do not scale off this drawing for construction purposes.
This drawing is the copyright of the architect, and must be reproduced without their permission.
Ordinance Survey map information reproduced with permission of HMSS Crown Copyright reserved.
Copyright: Building in 2022

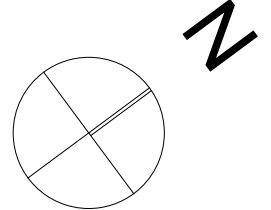

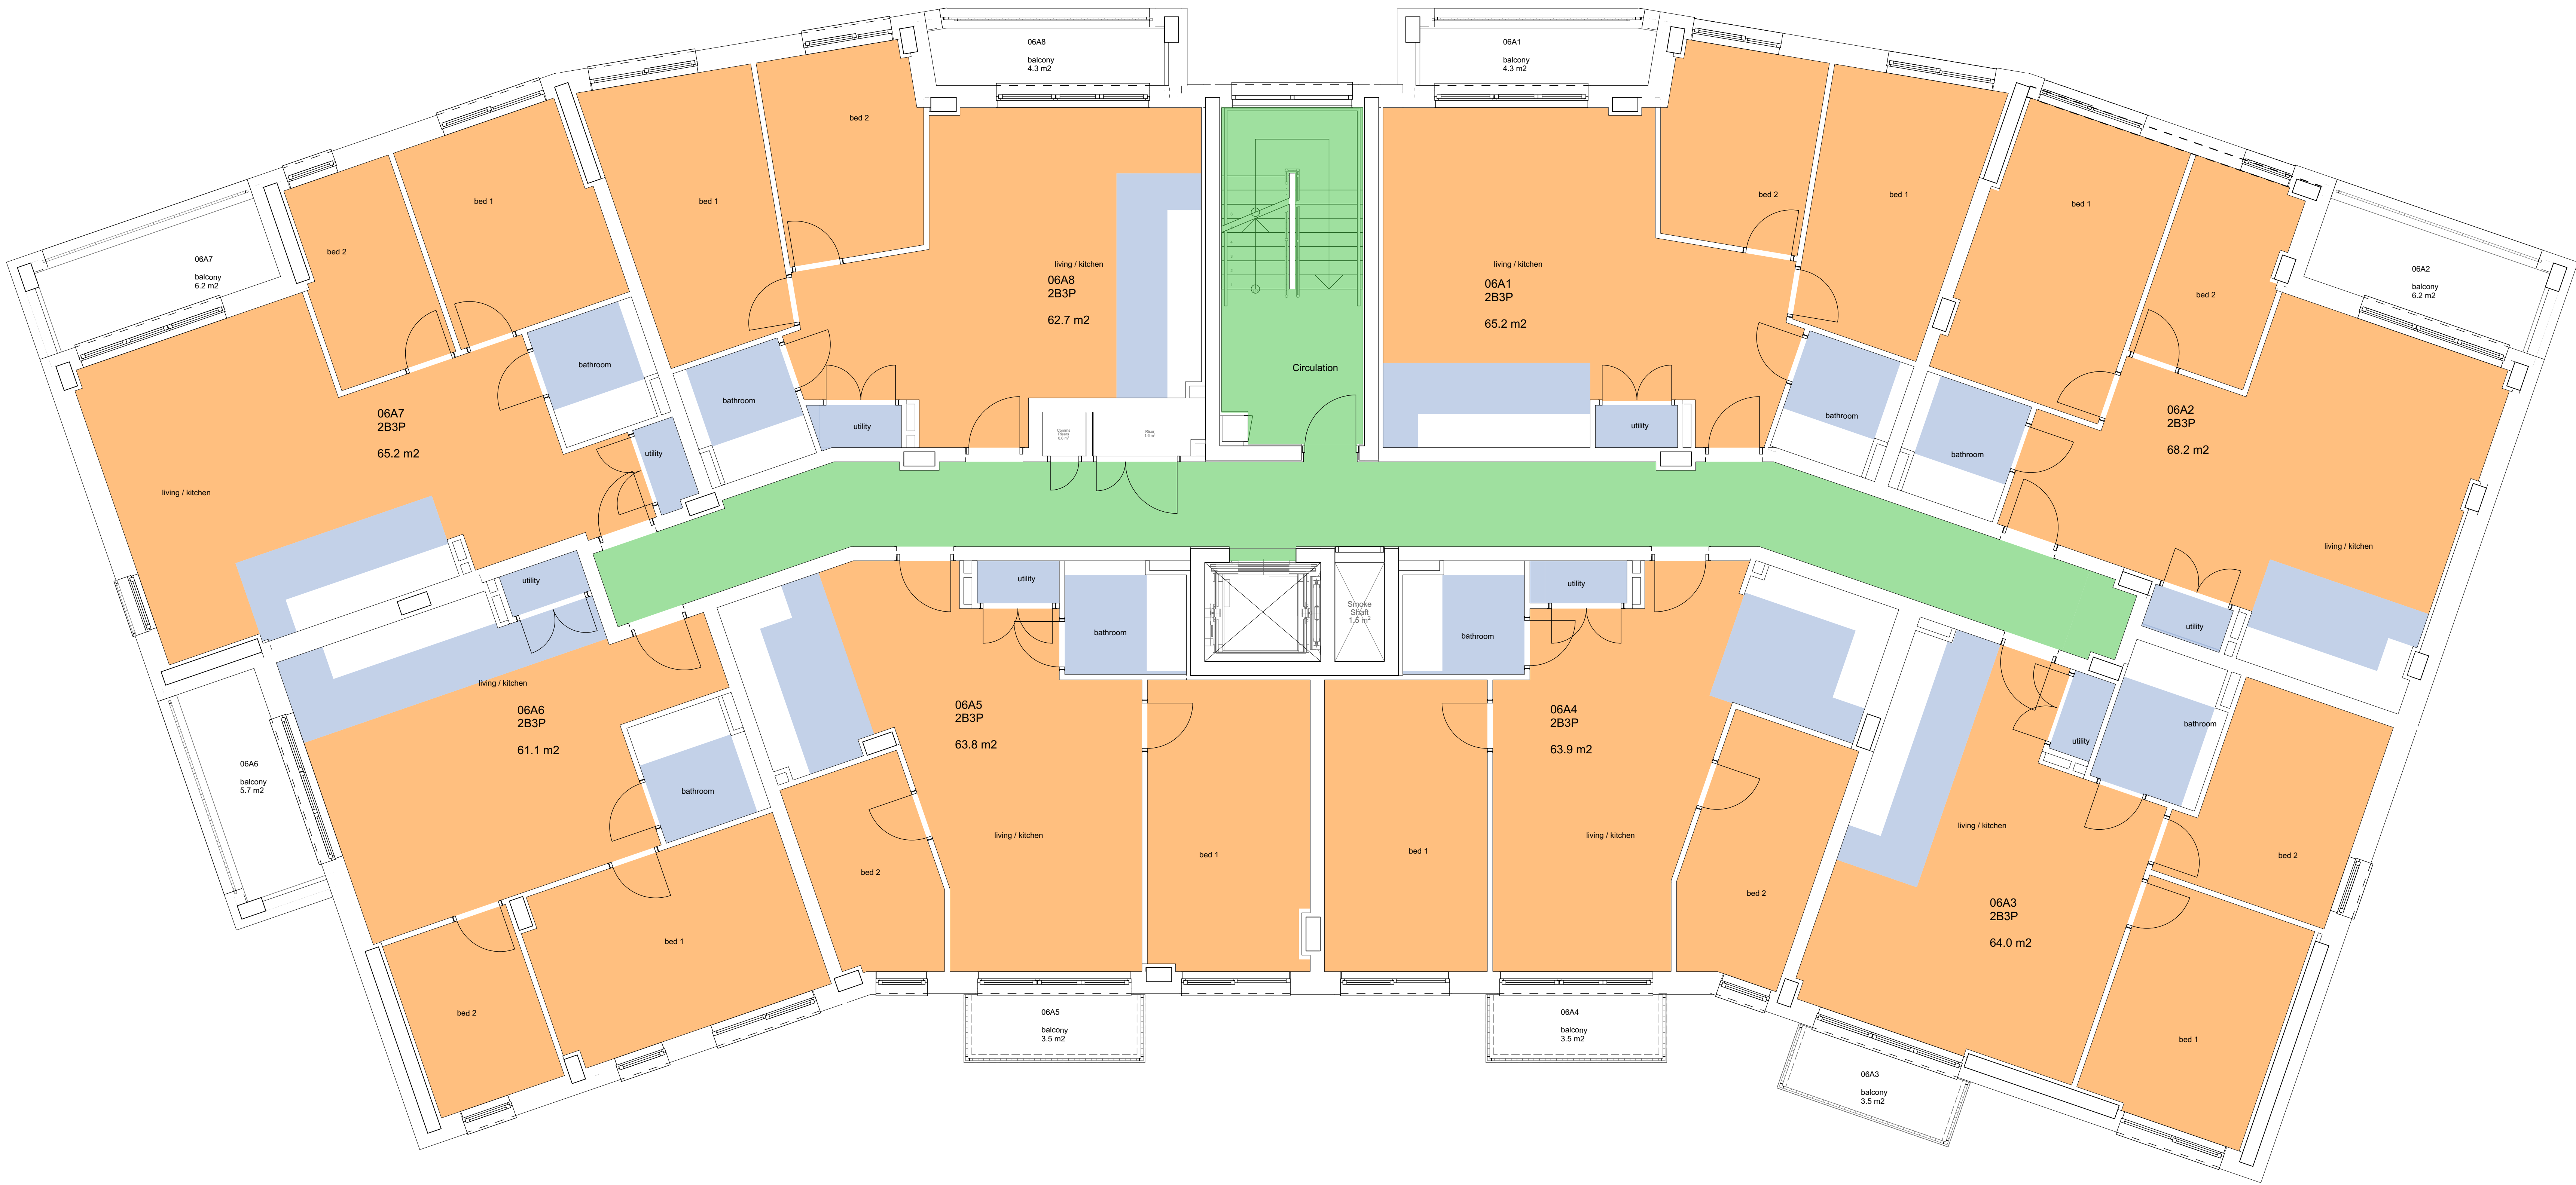


Floor Finish Key	
	Floor - NewtonPolyflex sheet vinyl
	Floor - Entrance areas will be provided with anti-burner, Gracast Boulevard 1500 or similar type entrance matting 1.2 m deep, colour from standard range available. Remaining floor area contract carpet tiles.
	Floor - Contract carpet tiles. Manufacturer: CFS Ilexion or CFS V1450, or acceptable equivalent. To staircases provide contract carpet tiles. Gracast aluminium nosings to all treads in contrasting colour.
	Plant rooms Floor - Watco paint non-slip grey finish
	UNKF - Genius carpet




Project:	Bletchley View North 100-331
Status:	CONSTRUCTION
Client:	Winvic Construction Ltd
Sheet title:	Floor finishes - 6th Floor Plan A
Scale:	1:50@A0
Date:	February 2023
Drawn:	NKZ
Checked:	THR

Ref: E21062-RGP-A-06-DR-A-1721-C02
London | Birmingham | Leicester
0203 327 0981 | 0121 599 0071 | 0116 204 5800
rg+p@winvic.co.uk | design@winvic.co.uk

Notes:
All drawings should be constructed in strict accordance with building regulations.
In addition any materials, components and fittings not be connected to a supply should be non-combustible (see the category of the building above D14).
All dimensions to be checked on site. Do not scale off this drawing for construction purposes.
This drawing is the copyright of the architect, and must be reproduced without their permission.
Ordinance Survey map information reproduced with permission of HMSS Crown Copyright reserved.
Copyright: 2023 Winvic

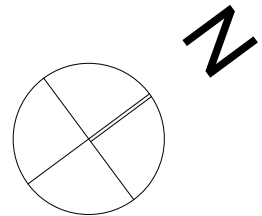

Revision:	Date:	Drawn:	Check:
C01 Construction issue	21/12/22	LD	SD
C02 Floor Finish Updated according to Clients Comments, issued on 25th Jan	13/02/23	NK2	THB
C03 Minor plan updates	28/6/23	LD	TH

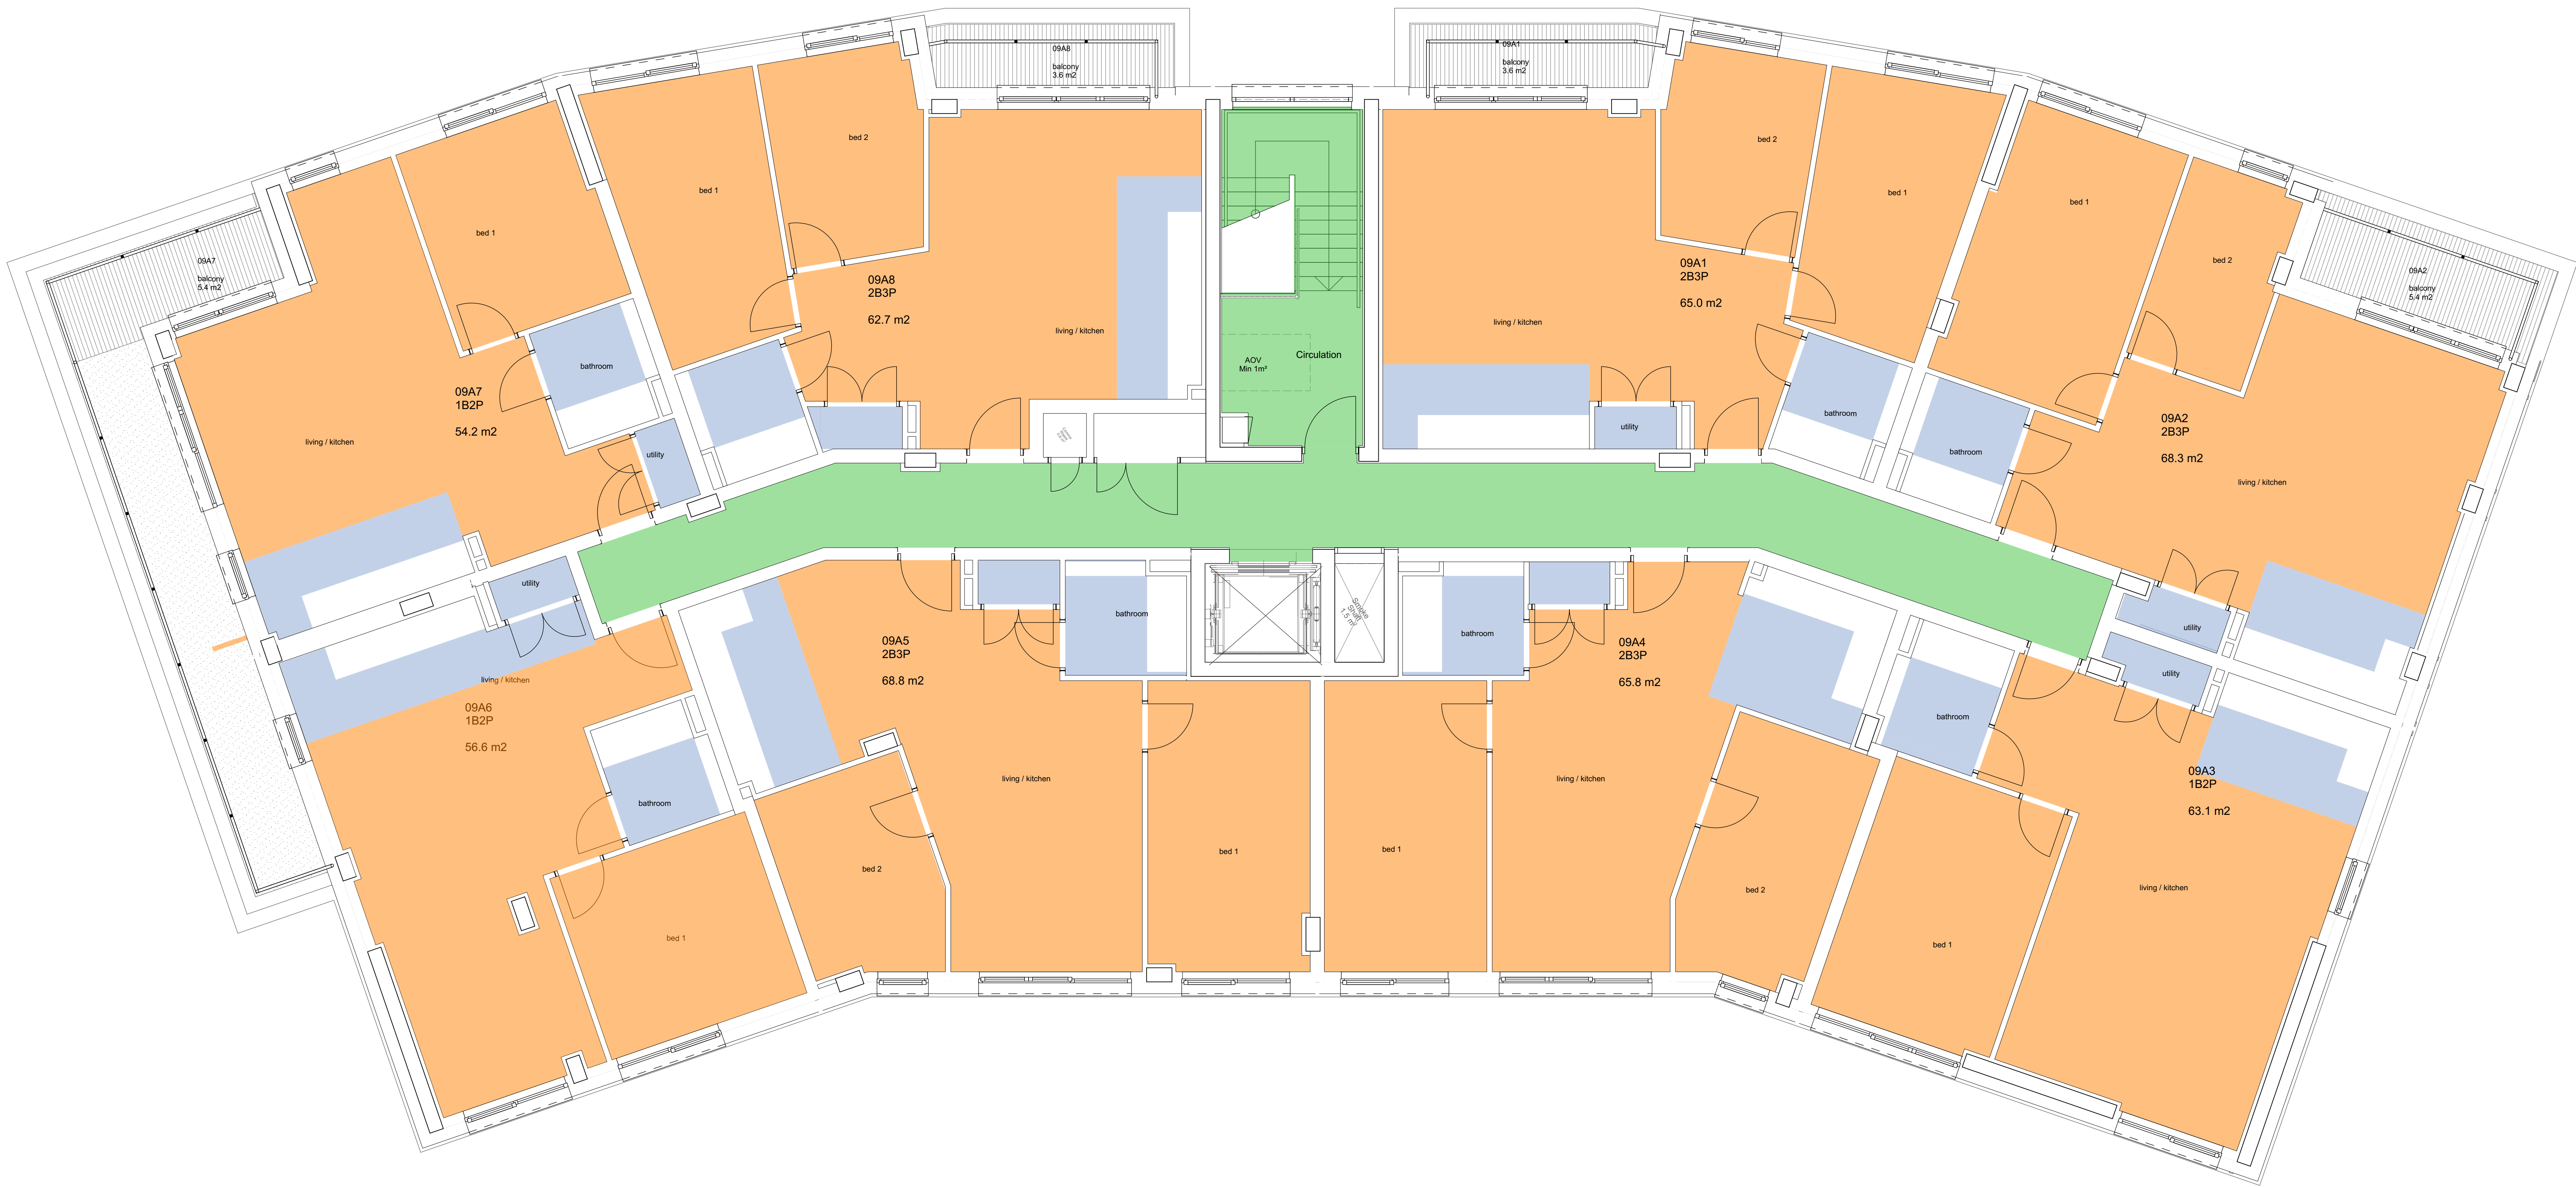

Floor Finish Key	
	Floor - NeovisonPolyflor sheet vinyl
	Floor - Entrance areas will be provided with anti-burner, Gracian Boulevard 1500 or similar type entrance matting 1.2 m deep, colour from standard range available. Remaining floor area contract carpet tiles.
	Floor - Contract carpet tiles. Manufacturer: CFS Ilexion or CFS V1450, or acceptable equivalent. To staircase provide contract carpet tiles. Gracian aluminium nosing's to all treads in contrasting colour.
	Plant rooms Floor - Watco paint non-slip grey finish
	UNKF- Genus carpet




Project:	Bletchley View North 100-331
Status:	CONSTRUCTION
Client:	Winvic Construction Ltd
Sheet title:	Floor finishes - Ninth Floor Plan A
Scale:	1:50@A0
Date:	December 2022
Drawn:	LD
Checked:	SD


Ref: E21062-RGP-A-09-DR-A-1704-C03

London | Birmingham | Leicester
0203 327 0941 | 0121 599 0071 | 0116 204 5800
rgp@winvic.co.uk design@rgp.co.uk

Notes:
All drawings should be constructed in strict accordance with building regulations.
In addition any materials, components and fittings to be connected to a supply should be non-combustible (see the notes on the drawings above D14).
All dimensions to be checked on site. Do not scale off this drawing for construction purposes.
This drawing is the copyright of the architect, and must be approved in writing prior to any reproduction.
Ordinance Survey map information reproduced with permission of HMDS Crown Copyright reserved.
Copyright: 2022 RGP

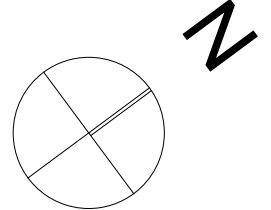

Revision:	Date:	Drawn:	Check:
C01 Construction Issue	21/12/22	LD	SD
C02 Floor Finish Updated according to Clients Comments, issued on 21st Jan	13/02/23	NKZ	THR
C03 Carpet added as client instruction	28/6/23	LO	TH

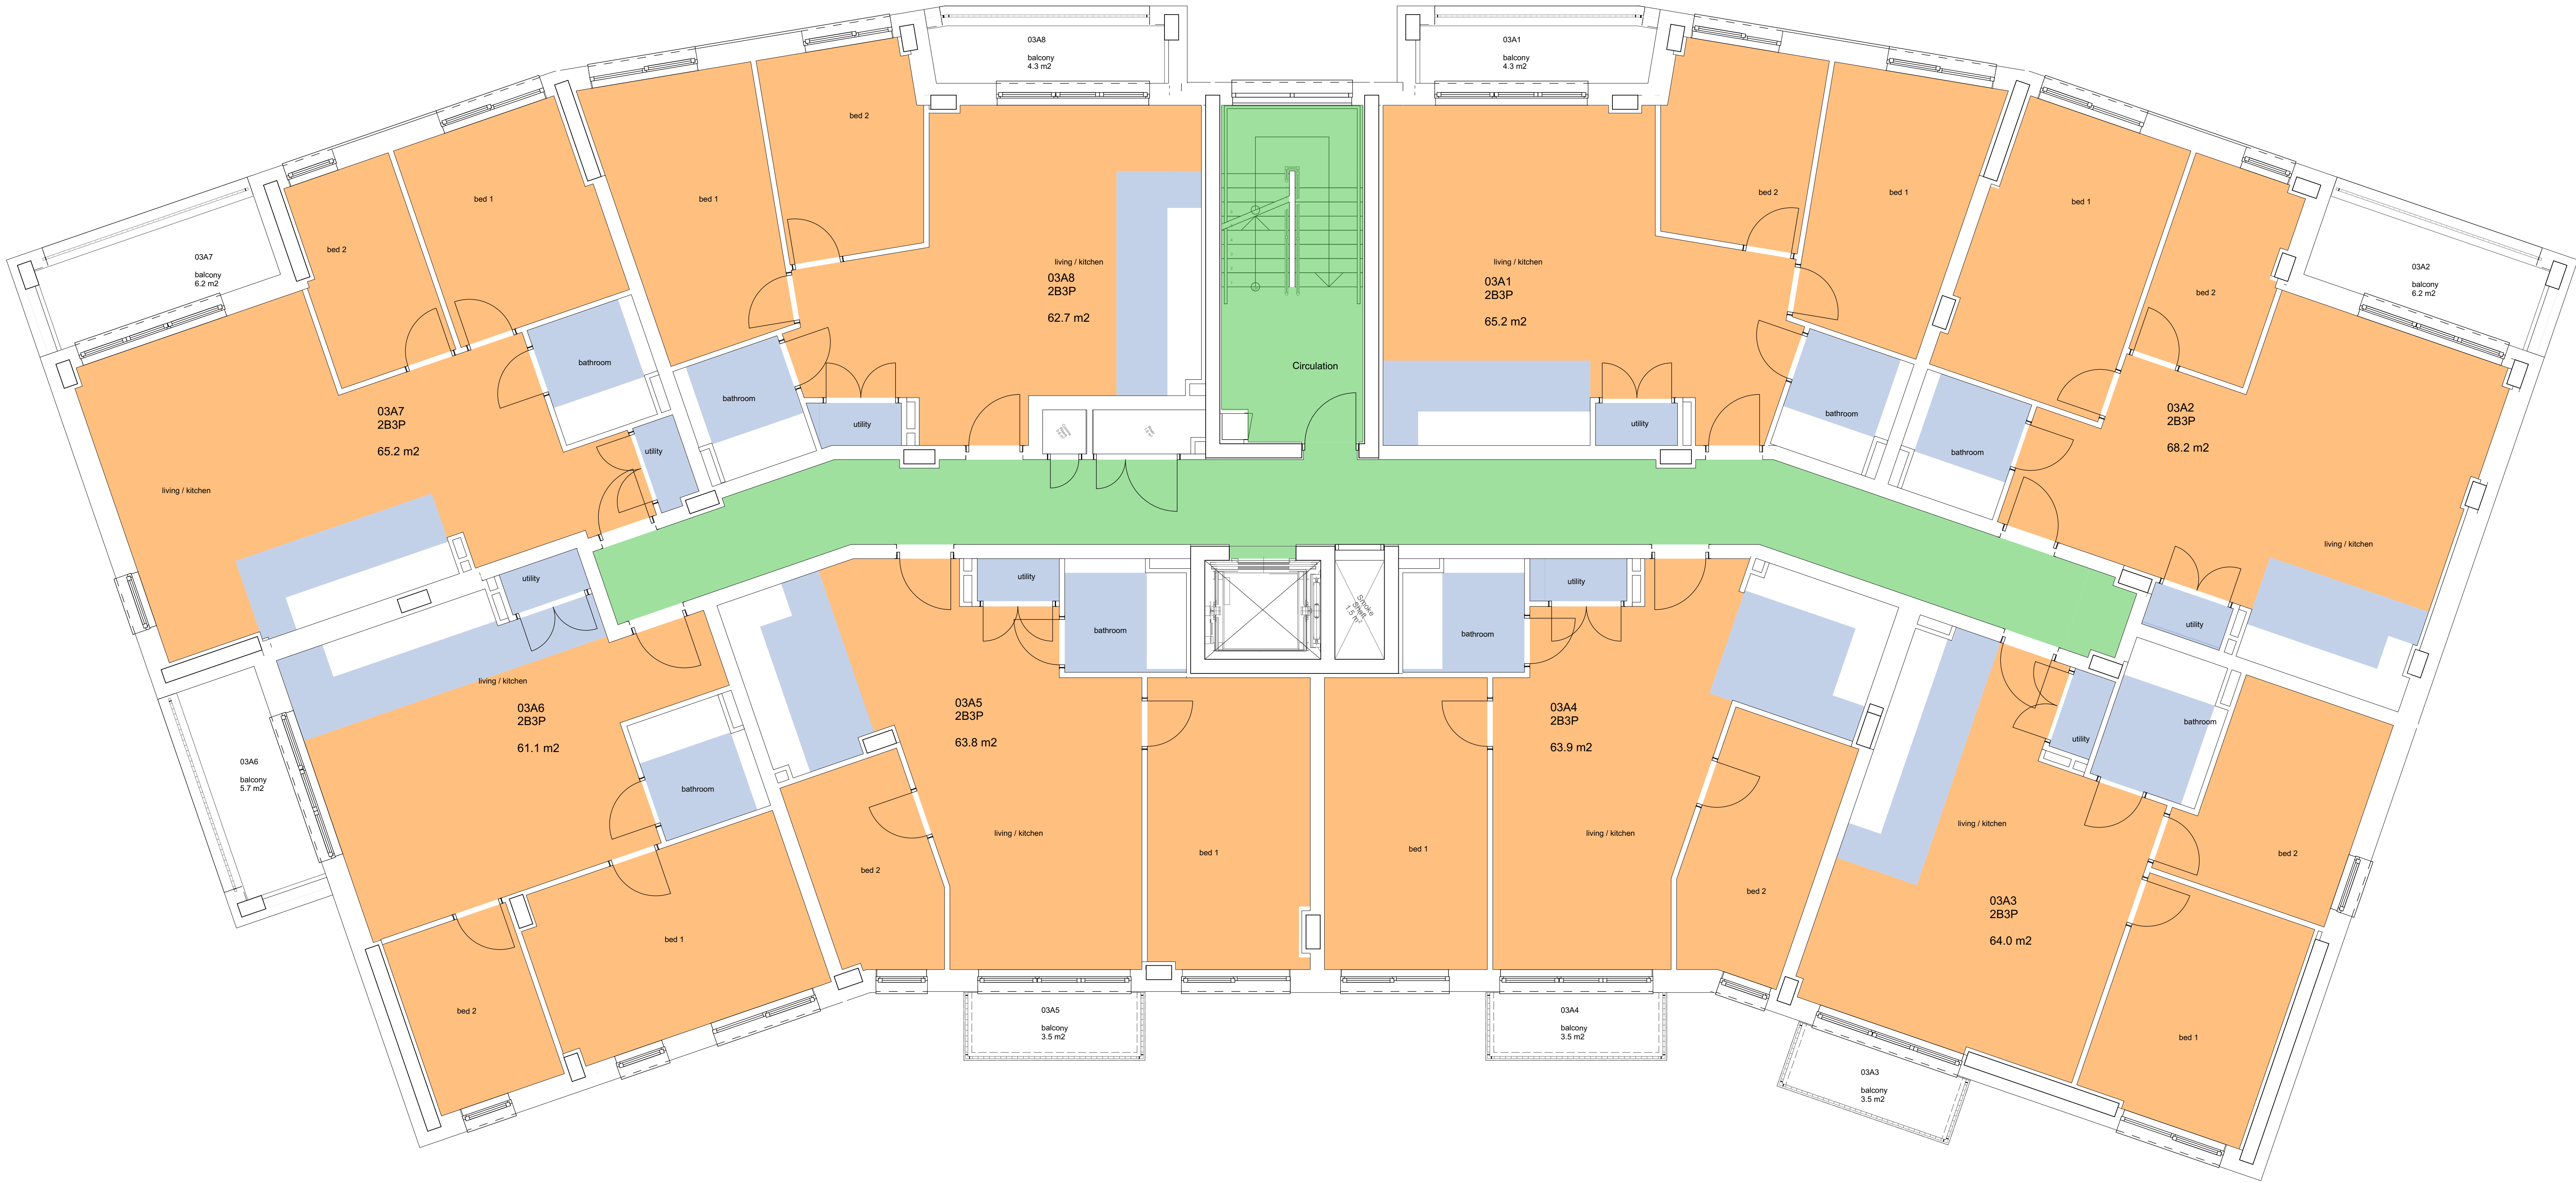


Floor Finish Key	
	Floor - NeovisonPolyflor sheet vinyl
	Floor - Entrance area will be provided with anti-bumper, Gracast Boulevard 1500 or similar type entrance matting 1.2 m deep, colour from standard range available. Remaining floor area contract carpet tiles.
	Floor - Contract carpet tiles. Manufacturer: CFS Iluxion or CFS V1450, or acceptable equivalent. To staircase provide contract carpet tiles. Gracast aluminium nosing's to all treads in contrasting colour.
	Plant rooms Floor - Watco paint non-slip grey finish
	UNKF- Genus carpet




Project:	Bletchley View North 100-331
Status:	CONSTRUCTION
Client:	Winvic Construction Ltd
Sheet title:	Floor finishes - 3rd to 5th Floor Plan A
Scale:	1:50@A0
Date:	December 2022
Drawn:	LD
Checked:	SD

Ref: E21062-RGP-A-SL-DR-A-1703-C03
London | Birmingham | Leicester
0203 327 0981 | 0121 599 0071 | 0116 204 5800
rgp@winvic.co.uk | design@rgp.co.uk

Notes:
All designs should be constructed in strict accordance with building regulations.
In addition any materials, components and fittings shall be certified to a grade suitable for the intended use.
All dimensions to be checked on site. Do not scale off this drawing for construction purposes.
This drawing is the copyright of the architect, and must be approved in writing prior to any reproduction.
Ordinance Survey map information reproduced with permission of HMDS Crown Copyright reserved.
Copyright: 2022

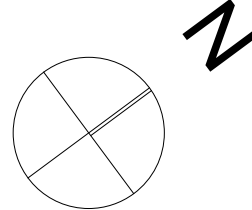

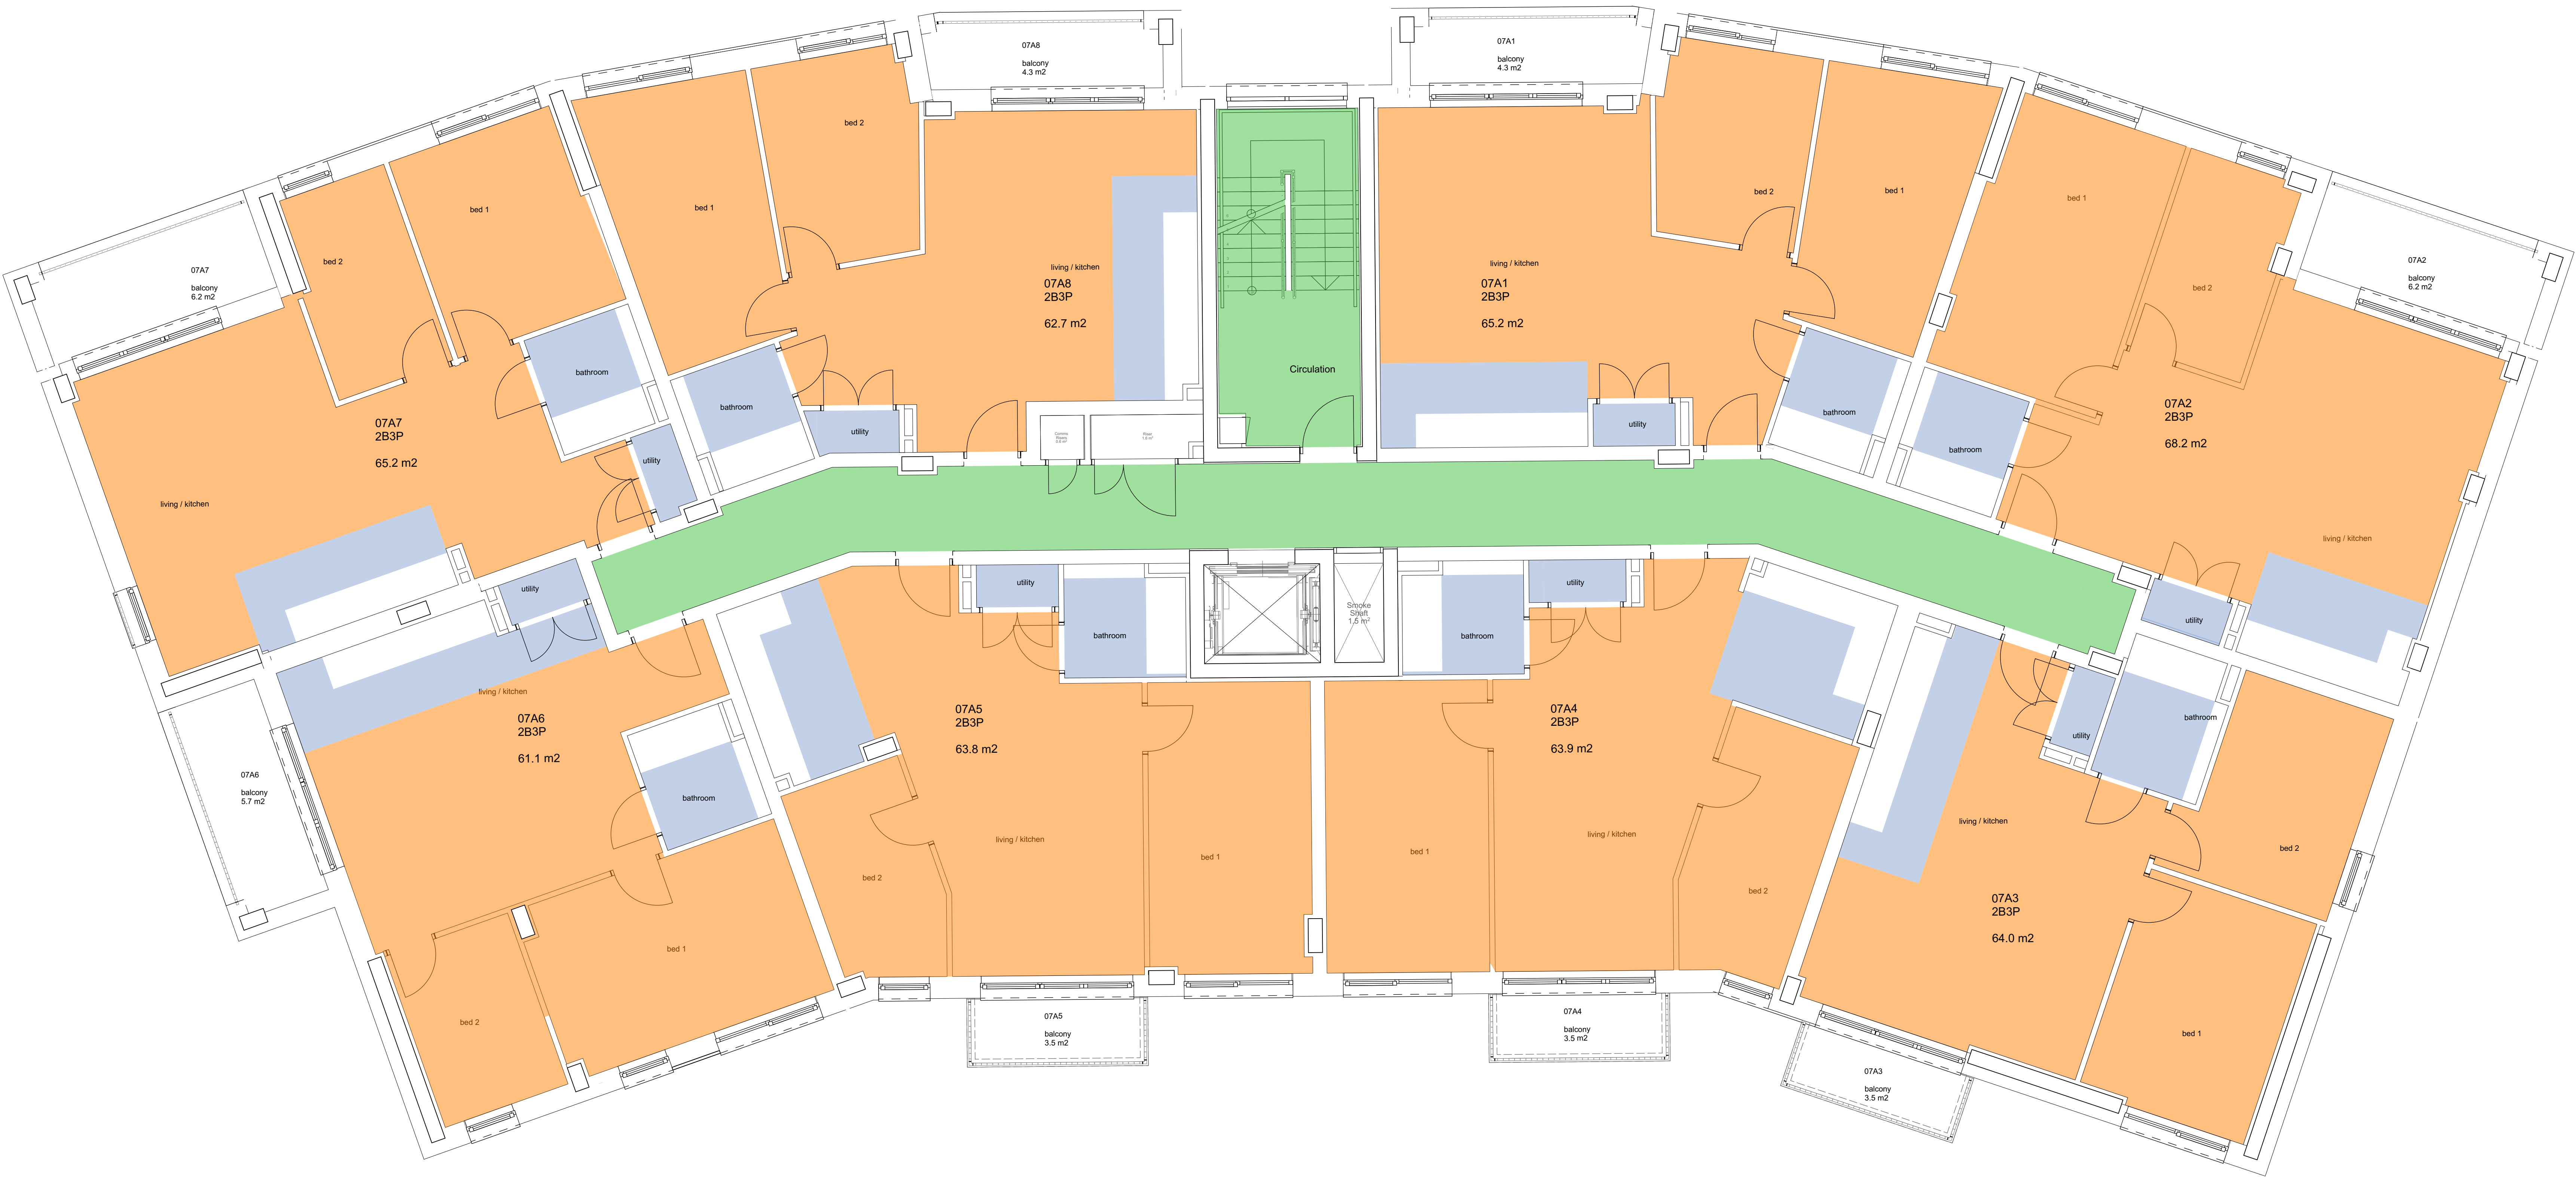

- Floor Finish Key**



Project: Bleckley View North
100-331

Status: **CONSTRUCTION**

Client: Winvic Construction Ltd

Sheet title: **Floor finishes - 7th to 8th Floor Plan A**

Scale: **1:50@A0**

Date: February 2023


Drawn: NKZ


Checked: THR

Ref: E21062-RGP-A-SL-DR-A-1722-C01

London | Birmingham | Leicester
0203 327 0981 | 0121 599 0071 | 0116 204 5800
rgp@winvic.co.uk | design@rgp.co.uk

Notes:
All designs should be constructed in strict accordance with building regulations.
In addition any materials, components and fittings shall be certified for a grade should be non-combustible fire test rating of the building above Dm.
All dimensions to be checked on site. Do not scale off this drawing for construction purposes.
This drawing is the copyright of the architect, and must be approved in writing prior to any reproduction.
Ordinance Survey map information reproduced with permission of HMSS Crown Copyright reserved.
Copyright: 2023

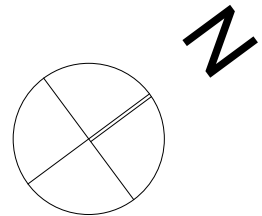

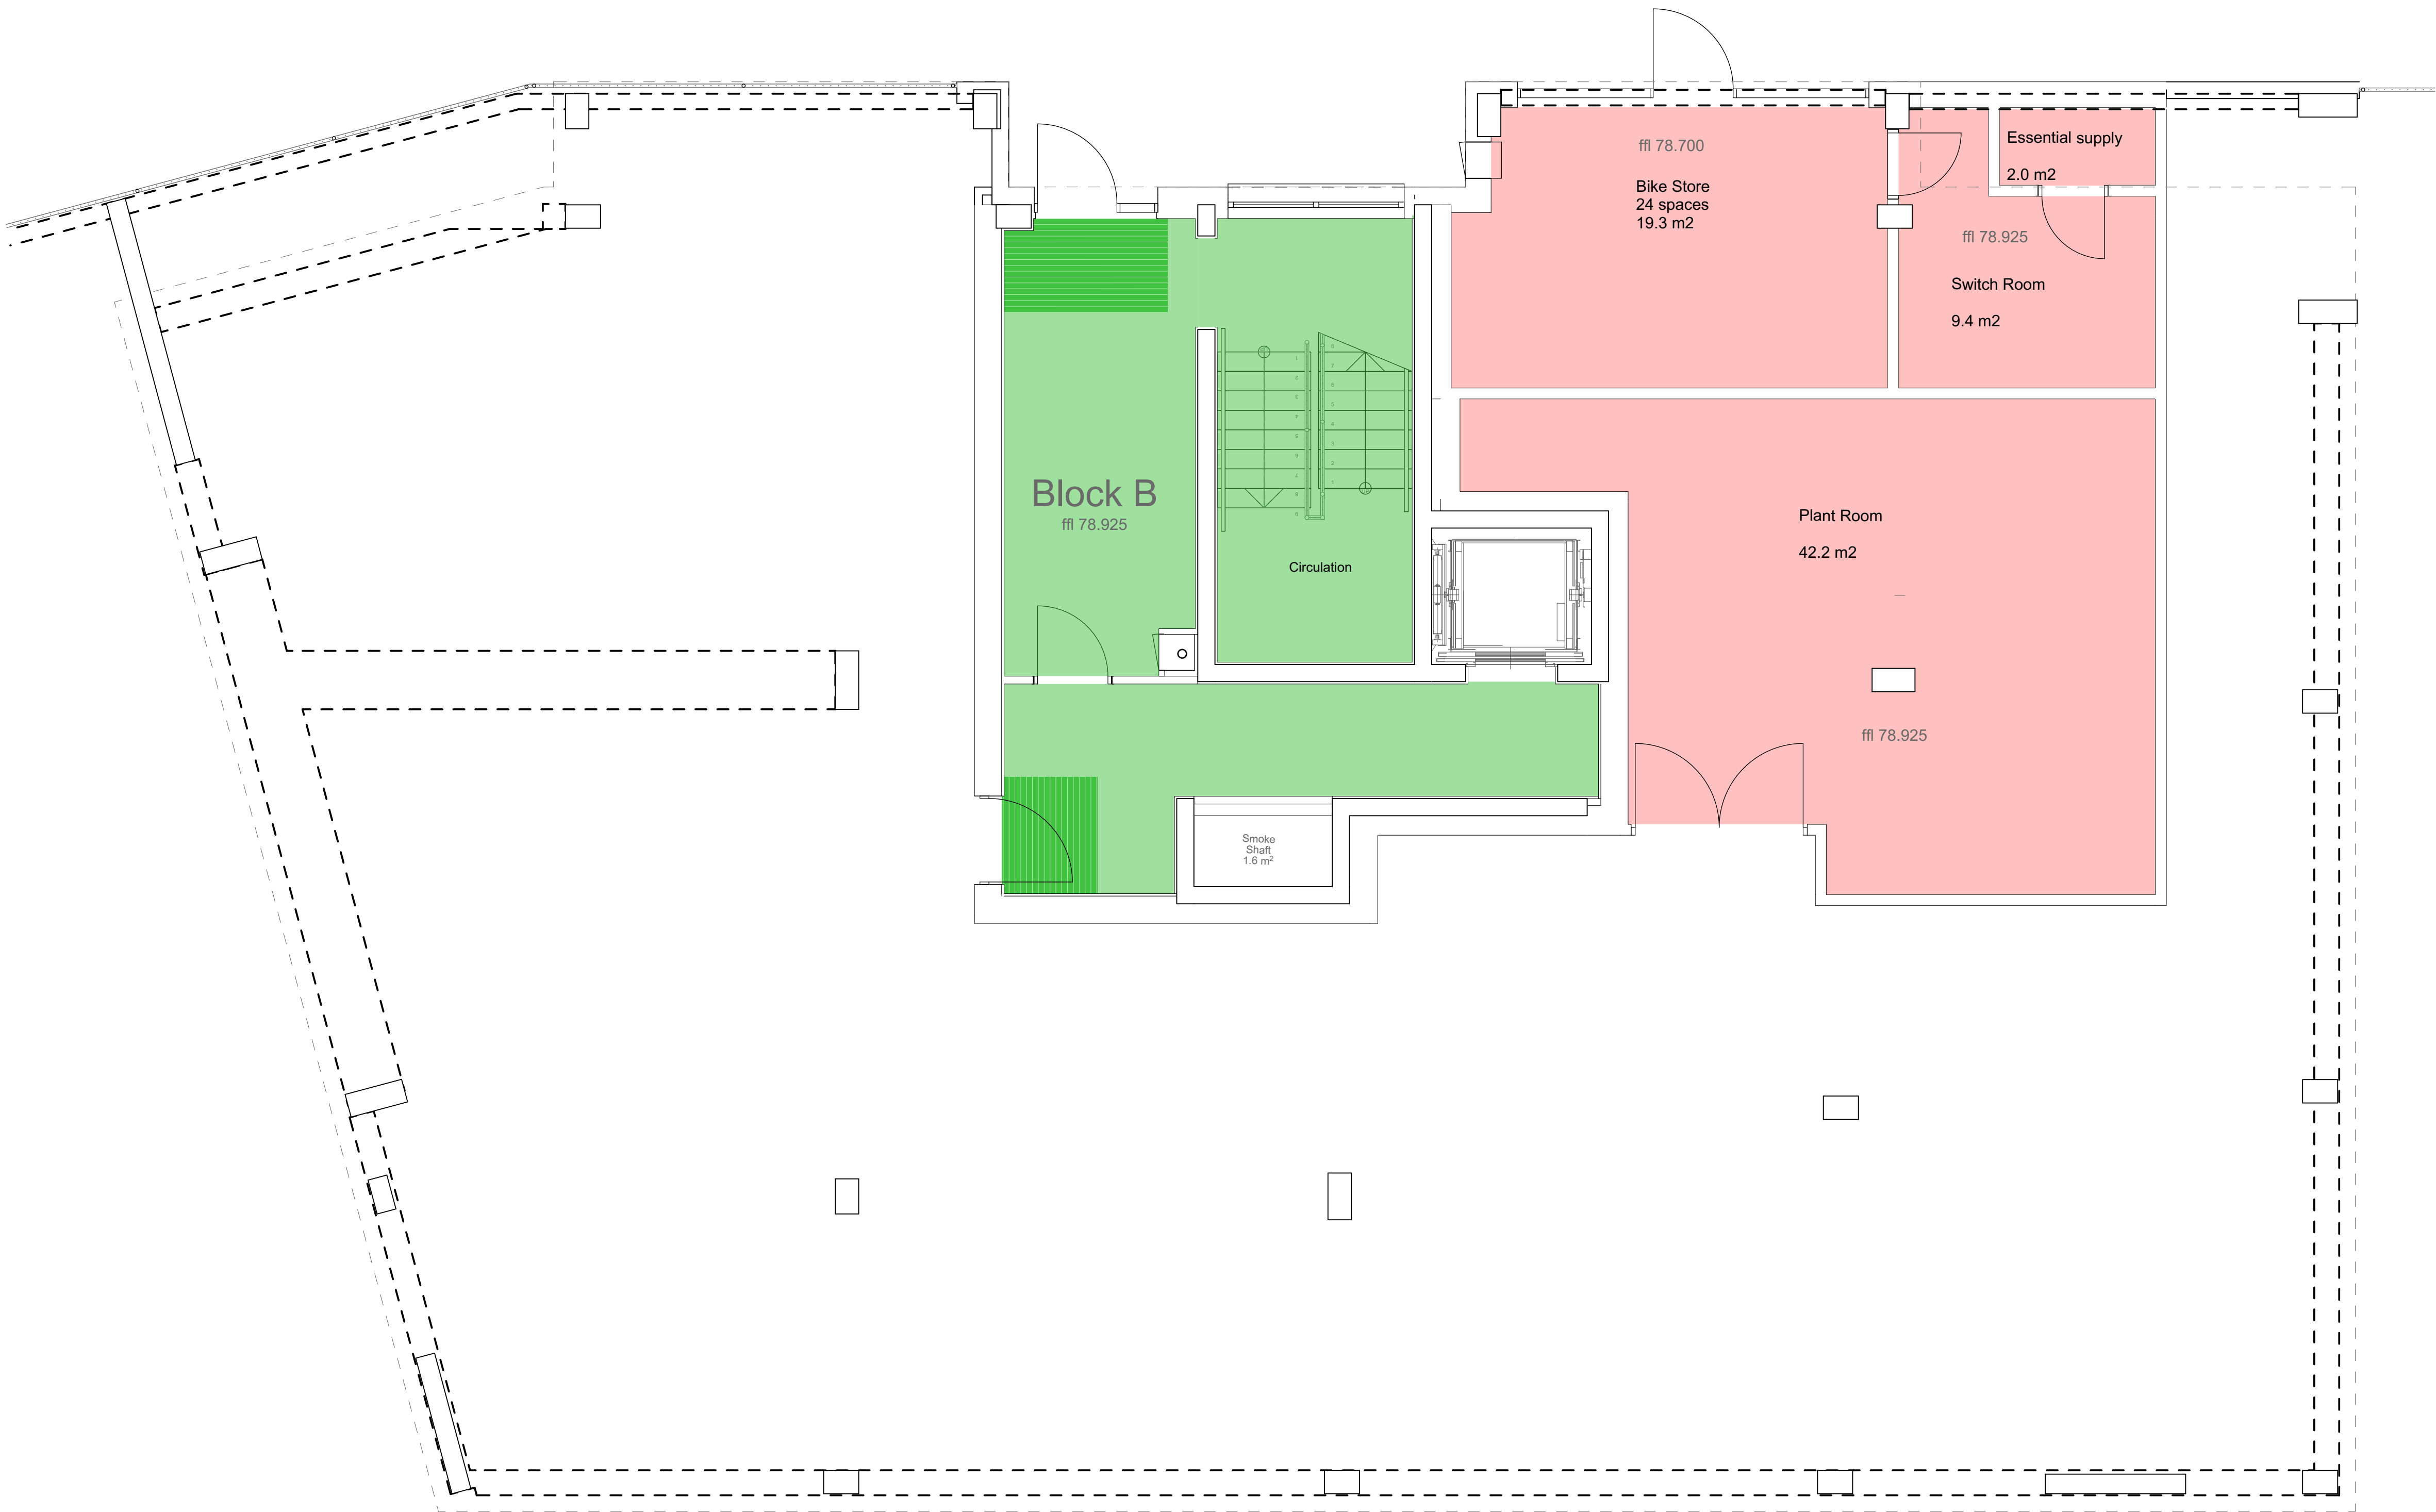


Floor Finish Key

- Floor - Novolon/Polyflor sheet vinyl
- Floor - Entrance area will be provided with dirt barrier, Gradus Boulevard 1500 or similar type entrance matting 1.2 m deep, colour from standard range available. Remaining floor area contract carpet tiles.
- Floor - Contract carpet tiles. Manufacturer: CFS Illusion or CFS VT490, or acceptable equivalent. To staircases provide contract carpet tiles. Gradus aluminium nosing's to all treads in contrasting colour.
- Plant rooms Floor - Watco paint finish



Project:	Bletchley View North 100-331
Status:	CONSTRUCTION
Client:	Winvic Construction Ltd
Sheet title:	Floor finishes - Ground Floor Plan Block B
Scale:	1:50@A1
Date:	December 2022
Drawn:	LD
Checked:	SD
Ref:	E21062-RGP-B-00-DR-A-2700-C01

Revision:	Date:	Drawn:	Check:
C01 Construction issue	21/12/22	LD	SD
C02 Floor Finish Updated according to Clients Comments, issued on 25th Jan.	13/02/23	NKZ	THR
C03 Carpet added as client instruction	28/6/23	LD	TH

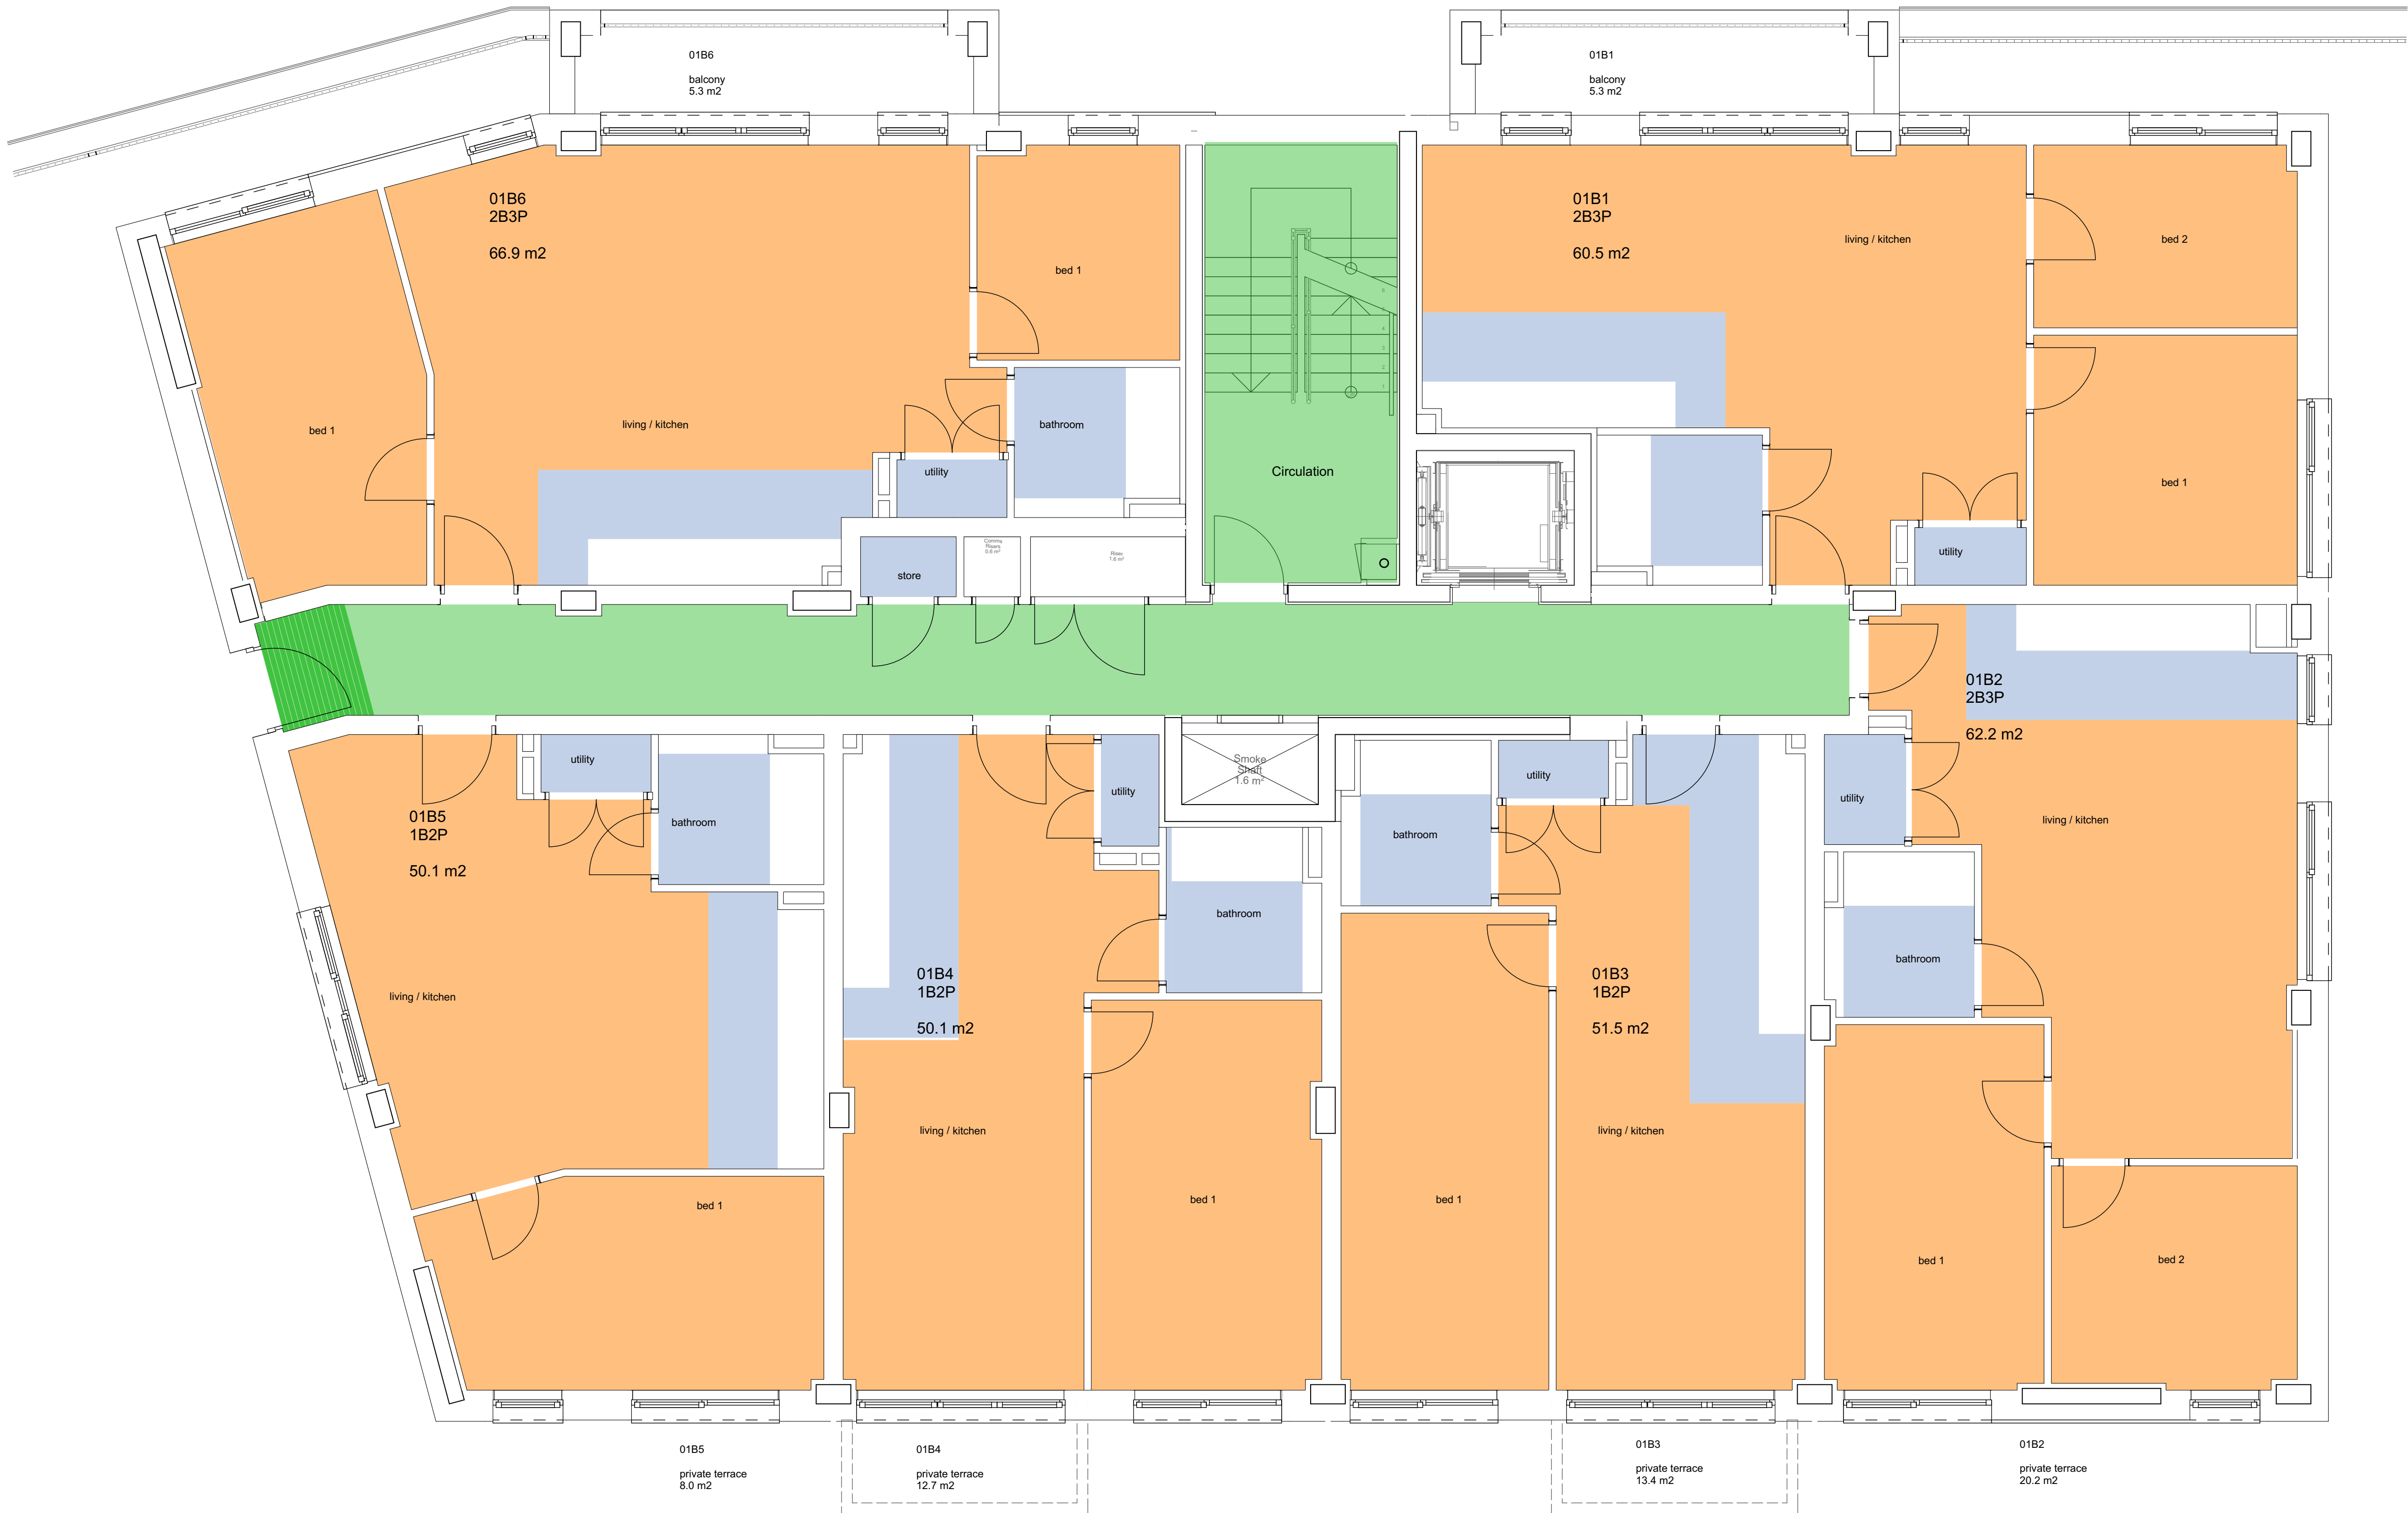

Project:	Bletchley View North 100-331
Status:	CONSTRUCTION
Client:	Winvic Construction Ltd
Sheet title:	Floor finishes - First Floor Plan Block B
Scale:	1:50@A1
Date:	December 2022
Drawn:	LD
Checked:	SD
Ref:	E21062-RGP-B-01-DR-A-2701-C03

London | Birmingham | Leicester
0203 327 0381 | 0121 309 0071 | 0116 204 5800
rg-p.co.uk · design@rg-p.co.uk

Notes
All designs should be constructed in strict accordance with building regulations.
In addition any materials, components and fixings in/or connected to a façade should be non-combustible if the top storey of the building is above 11m.
All dimensions to be checked on site. Do not scale off this drawing for construction purposes.
This drawing is the copyright of the Architect, and not to be reproduced without their permission.
Ordnance Survey map information reproduced with permission of HMSSD Crown Copyright reserved.
rg-p Ltd. Trading as rg-p

Revision:	Date:	Drawn:	Check:
C01 Construction issue	21/12/22	LD	SD
C02 Floor Finish Updated according to Clients Comments, issued on 25th Jan.	13/02/23	NKZ	THR
C03 Carpet added as client instruction	28/6/23	LD	TH



Floor Finish Key	
	Floor - Novolon/Polyflor sheet vinyl
	Floor - Entrance area will be provided with dirt barrier, Gradus Boulevard 1500 or similar type entrance matting 1.2 m deep, colour from standard range available. Remaining floor area contract carpet tiles.
	Floor - Contract carpet tiles. Manufacturer: CFS Illusion or CFS VT480, or acceptable equivalent. To staircases provide contract carpet tiles. Gradus aluminium nosing's to all treads in contrasting colour.
	Plant rooms Floor - Watco paint non-slip grey finish
	UKF- Genius carpet



Project:	Bletchley View North 100-331
Status:	CONSTRUCTION
Client:	Winvic Construction Ltd
Sheet title:	Floor finishes - 2nd Floor Plan Block B
Scale:	1:50@A1
Date:	December 2022
Drawn:	LD
Checked:	SD
Ref:	E21062-RGP-B-02-DR-A-2702-C03

London | Birmingham | Leicester
0203 327 0381 | 0121 309 0071 | 0116 204 5800
rg-p.co.uk · design@rg-p.co.uk

Notes
All designs should be constructed in strict accordance with building regulations.
In addition any materials, components and fixings in/or connected to a façade should be non-combustible if the top storey of the building is above 11m.

All dimensions to be checked on site. Do not scale off this drawing for construction purposes.
This drawing is the copyright of the Architect, and not to be reproduced without their permission.
Ordnance Survey map information reproduced with permission of HMSSO Crown Copyright reserved.
rg-p Ltd. Trading as rg-p



Floor Finish Key

- Floor - Novolon/Polyflor sheet vinyl
- Floor - Entrance area will be provided with dirt barrier, Gradus Boulevard 1500 or similar type entrance matting 1.2 m deep, colour from standard range available. Remaining floor area contract carpet tiles.
- Floor - Contract carpet tiles. Manufacturer: CFS Illusion or CFS VT400, or acceptable equivalent. To staircases provide contract carpet tiles. Gradus aluminium nosing's to all treads in contrasting colour.
- Plant rooms Floor - Watco paint finish
- UKF- Genius carpet



Project:	Bletchley View North 100-331
Status:	CONSTRUCTION
Client:	Winvic Construction Ltd
Sheet title:	Floor finishes - 6th Floor Plan Block B
Scale:	1:50@A1
Date:	December 2022
Drawn:	NKZ
Checked:	THR

Revision:	Date:	Drawn:	Check:
C01- Construction issue	21/12/22	LD	SD
C02- Floor Finish Updated according to Clients Comments, issued on 25th Jan.	13/02/23	NKZ	THR
C03- Minor plan updates	28/6/23	LD	TH



Floor Finish Key	
	Floor - Novolon/Polyflor sheet vinyl
	Floor - Entrance area will be provided with dirt barrier, Gradus Boulevard 1500 or similar type entrance matting 1.2 m deep, colour from standard range available. Remaining floor area contract carpet tiles.
	Floor - Contract carpet tiles. Manufacturer: CFS Illusion or CFS VT450. or acceptable equivalent. To staircases provide contract carpet tiles. Gradus aluminium nosing's to all treads in contrasting colour.
	Plant rooms Floor - Watco paint non-slip grey finish
	UKF- Genius carpet



Project:	Bletchley View North 100-331
Status:	CONSTRUCTION
Client:	Winvic Construction Ltd
Sheet title:	Floor finishes - Seventh Floor Plan Block B
Scale:	1:50@A1
Date:	December 2022
Drawn:	LD
Checked:	SD
Ref:	E21062-RGP-B-07-DR-A-2704-C03

London | Birmingham | Leicester
0203 327 0381 | 0121 309 0071 | 0116 204 5800
rg-p.co.uk · design@rg-p.co.uk

Notes
All designs should be constructed in strict accordance with building regulations.
In addition any materials, components and fixings in/or connected to a façade should be non-combustible if the top storey of the building is above 11m.

All dimensions to be checked on site. Do not scale off this drawing for construction purposes.
This drawing is the copyright of the Architect, and not to be reproduced without their permission.
Ordnance Survey map information reproduced with permission of HMSSD Crown Copyright reserved.
rg-p Ltd. Trading as rg-p

Revision:	Date:	Drawn:	Check:
C01 Construction issue	21/12/22	LD	SD
C02 Drawing title amended to omit floor 6	16/02/23	NKZ	THR
C03 Carpet added as client instruction	28/6/23	LD	TH




Floor Finish Key

- Floor - Novolon/Polyflor sheet vinyl
- Floor - Entrance area will be provided with dirt barrier, Gradus Boulevard 1500 or similar type entrance matting 1.2 m deep, colour from standard range available. Remaining floor area contract carpet tiles.
- Floor - Contract carpet tiles. Manufacturer: CFS Illusion or CFS VT480, or acceptable equivalent. To staircases provide contract carpet tiles. Gradus aluminium nosing's to all treads in contrasting colour.
- Plant rooms Floor - Watco paint non-slip grey finish
- UKF- Genius carpet



Project:	Bletchley View North 100-331
Status:	CONSTRUCTION
Client:	Winvic Construction Ltd
Sheet title:	Floor finishes - 3rd to 5th Floor Plan Block B
Scale:	1:50@A1
Date:	December 2022
Drawn:	LD
Checked:	SD
Ref:	E21062-RGP-B-SL-DR-A-2703-C03

Revision:	Date:	Drawn:	Check:
C01 Construction issue	21/12/22	LD	SD
C02 Floor Finish Updated according to Clients Comments, issued on 25th Jan.	13/02/23	NKZ	THR

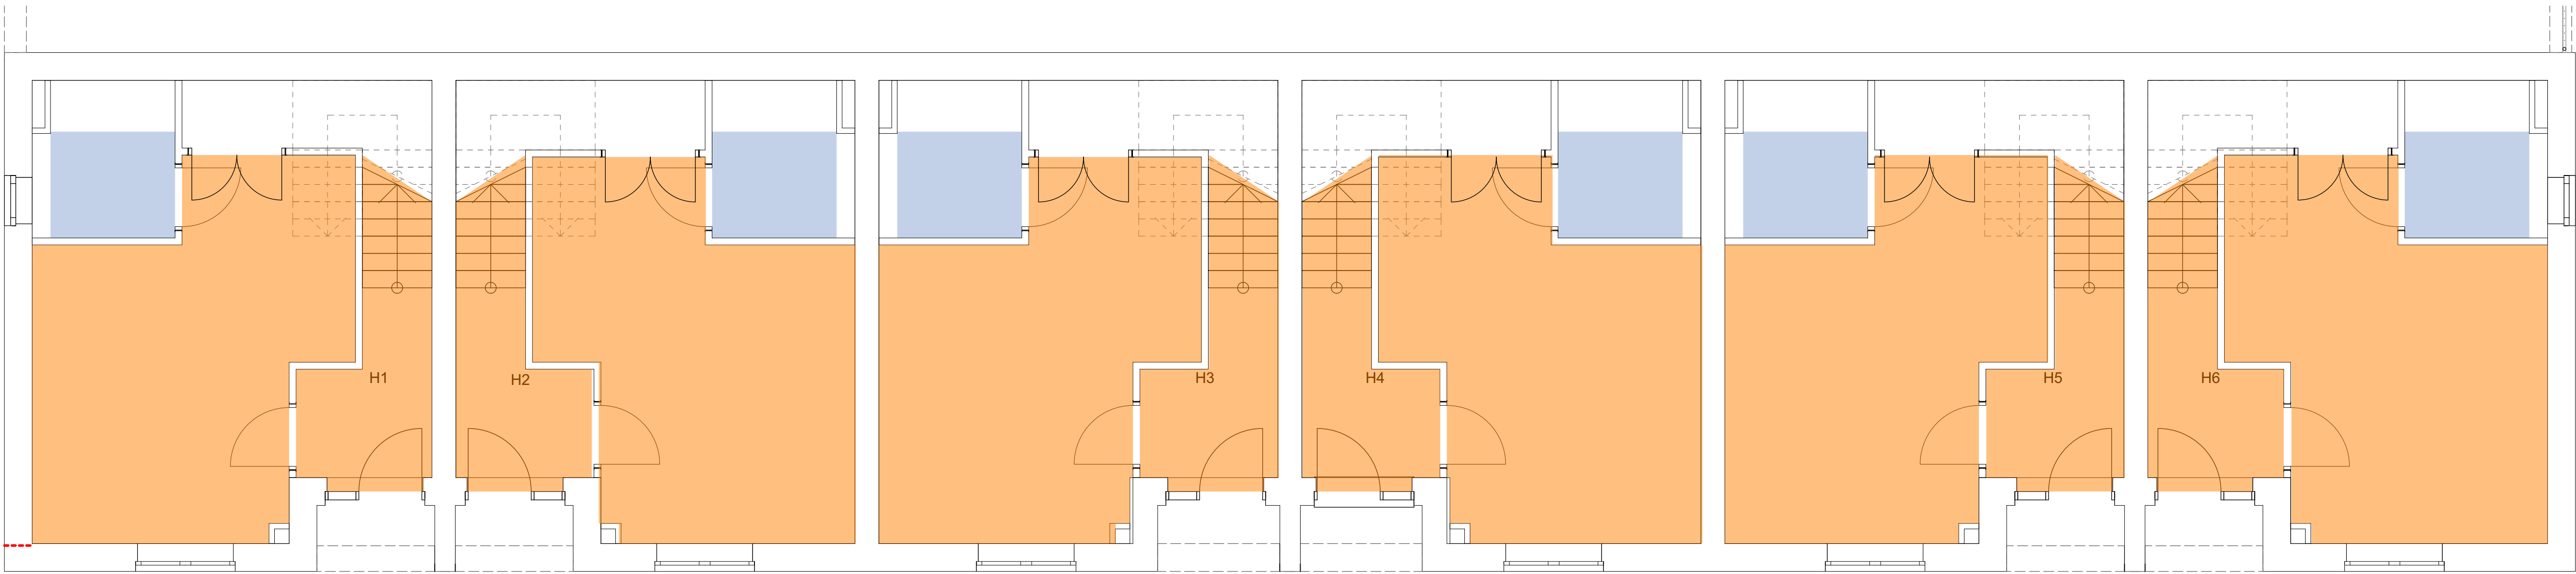


Floor Finish Key	
	Floor - Novolon/Polyflor sheet vinyl
	UKF- Genius carpet





Project:	Bletchley View North 100-331
Status:	CONSTRUCTION
Client:	Winvic Construction Ltd
Sheet title:	Floor finishes - Ground Floor Plan C
Scale:	1:50@A1
Date:	December 2022
Drawn:	LD
Checked:	SD
Ref:	E21062-RGP-C-00-DR-A-3700-C02

London | Birmingham | Leicester
0203 327 0381 | 0121 309 0071 | 0116 204 5800
rg-p.co.uk · design@rg-p.co.uk

Notes
All designs should be constructed in strict accordance with building regulations.
In addition any materials, components and fixings in/or connected to a façade should be non-combustible if the top storey of the building is above 11m.
All dimensions to be checked on site. Do not scale off this drawing for construction purposes.
This drawing is the copyright of the Architect, and not to be reproduced without their permission.
Ordnance Survey map information reproduced with permission of HMSSO Crown Copyright reserved.
rg-p Ltd. Trading as rg+p

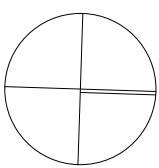


N

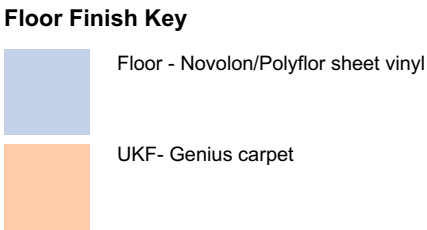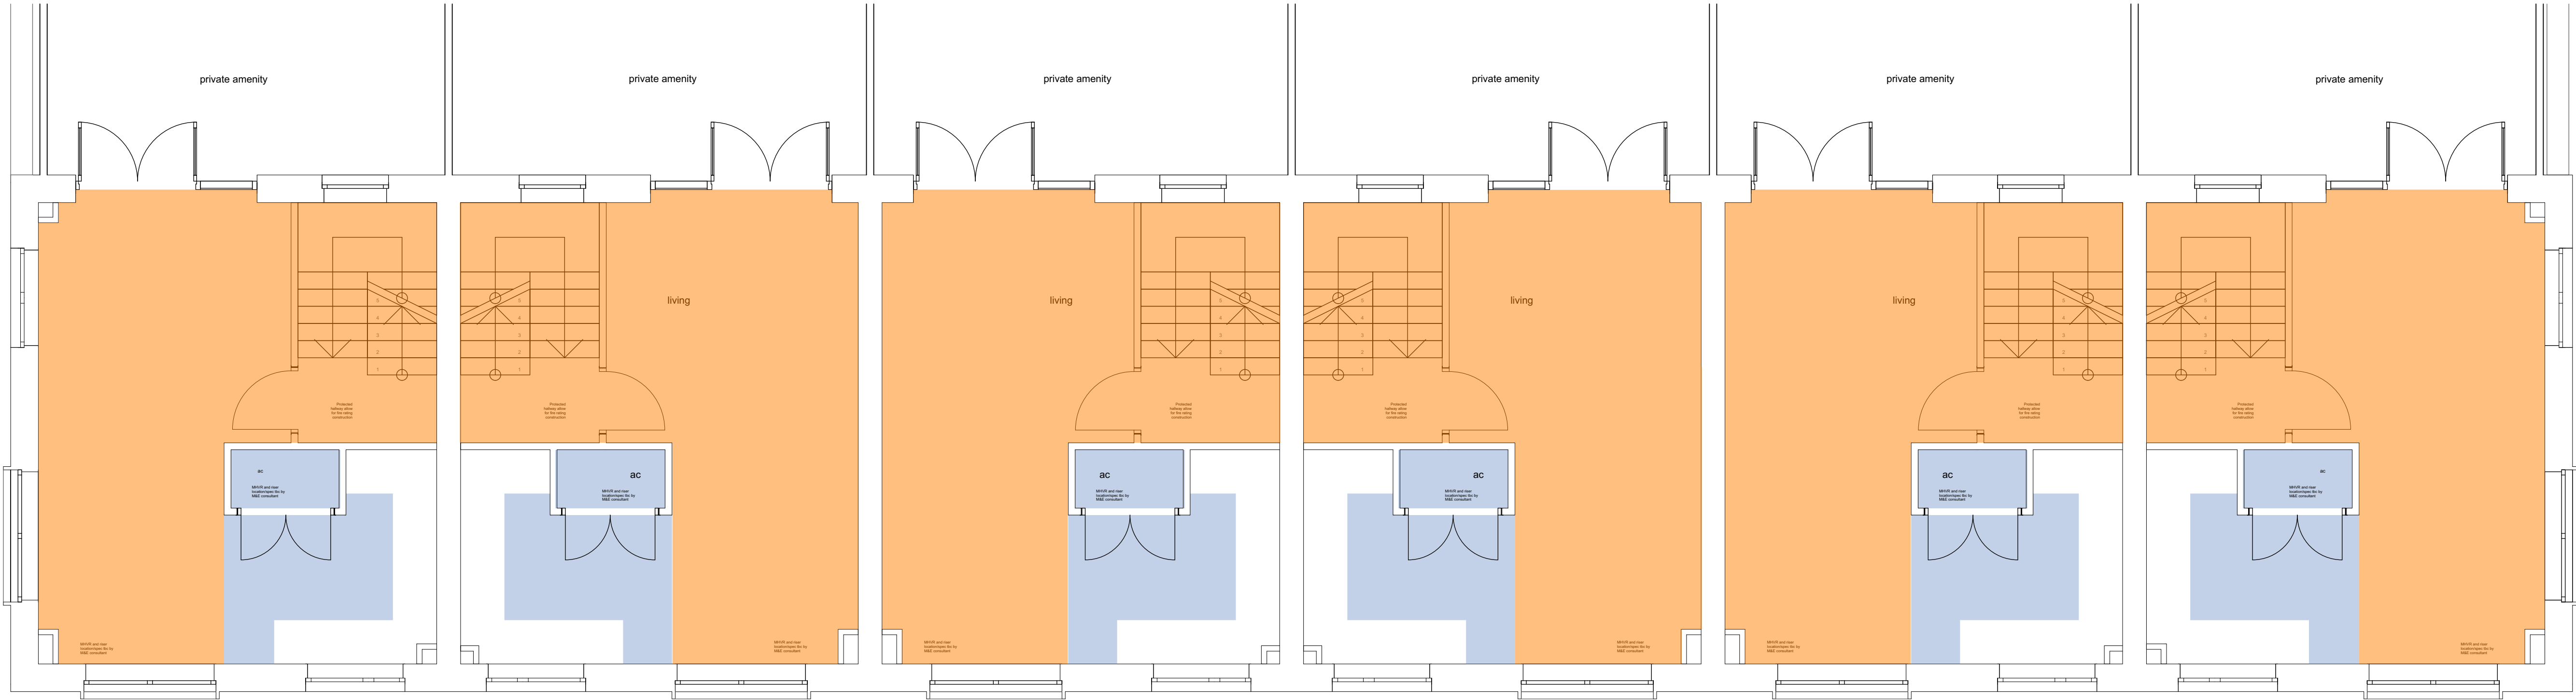

Project:	Bletchley View North 100-331
Status:	CONSTRUCTION
Client:	Winvic Construction Ltd
Sheet title:	Floor finishes - First Floor Plan C
Scale:	1:50@A1
Date:	December 2022
Drawn:	LD
Checked:	SD

Revision:	Date:	Drawn:	Check:
C01 Construction issue	21/12/22	LD	SD
C02 Floor Finish Updated according to Clients Comments, issued on 25th Jan.	13/02/23	NKZ	THR

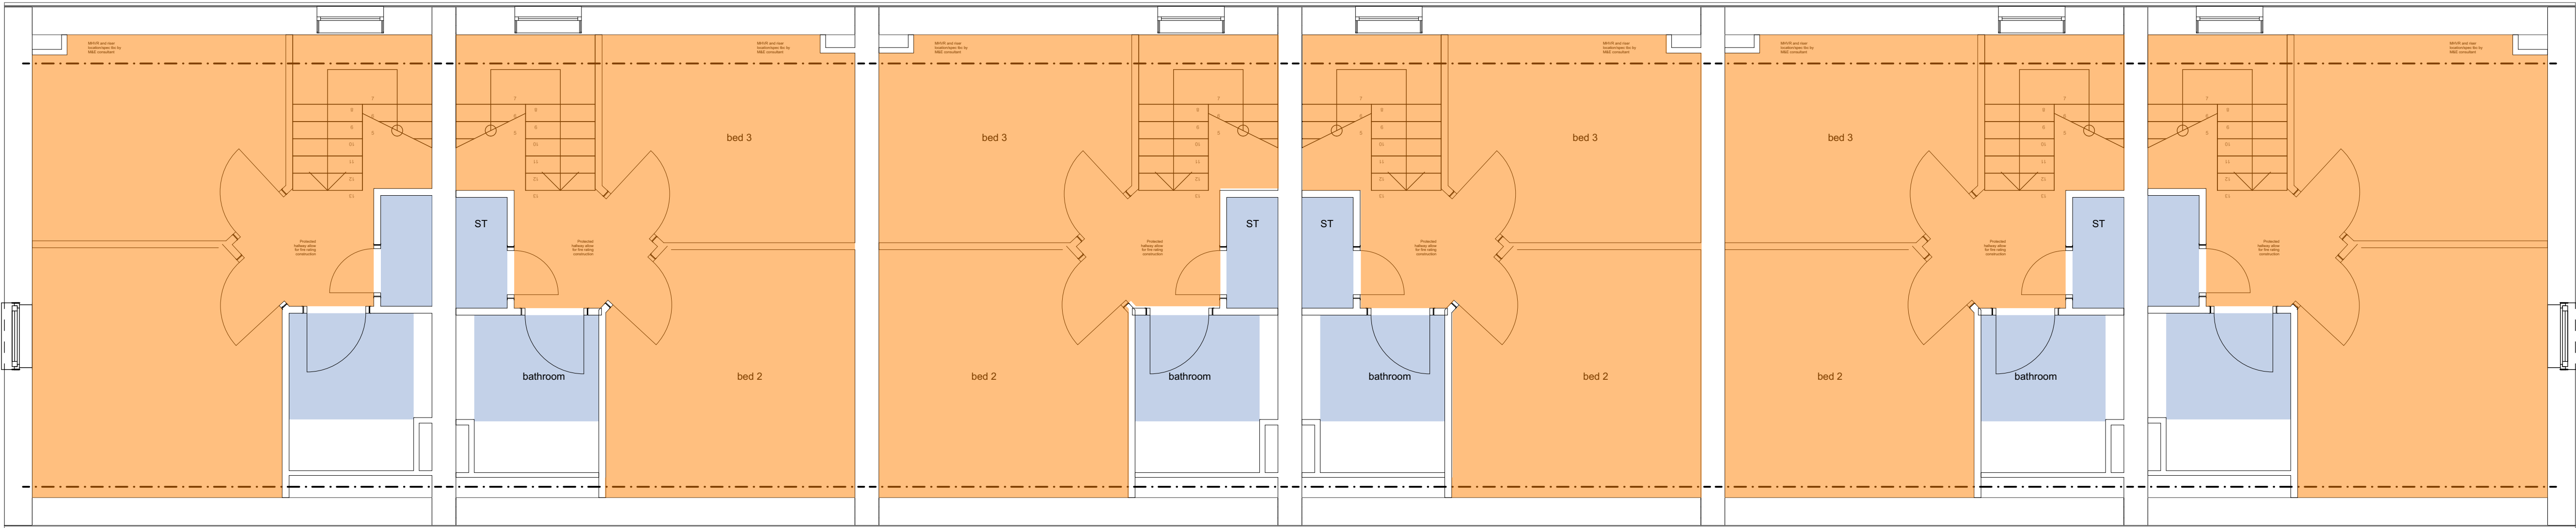


Floor Finish Key	
	Floor - Novolon/Polyflor sheet vinyl
	UKF- Genius carpet



Project:	Bletchley View North 100-331
Status:	CONSTRUCTION
Client:	Winvic Construction Ltd
Sheet title:	Floor finishes - Second Floor Plan C
Scale:	1:50@A1
Date:	December 2022
Drawn:	LD
Checked:	SD
Ref:	E21062-RGP-C-02-DR-A-3702-C02

London | Birmingham | Leicester
0203 327 0381 | 0121 309 0071 | 0116 204 5800
rg-p.co.uk · design@rg-p.co.uk

Notes
All designs should be constructed in strict accordance with building regulations.
In addition any materials, components and fixings in/or connected to a façade should be non-combustible if the top storey of the building is above 11m.
All dimensions to be checked on site. Do not scale off this drawing for construction purposes.
This drawing is the copyright of the Architect, and not to be reproduced without their permission.
Ordnance Survey map information reproduced with permission of HM&SO Crown Copyright reserved.
rg-p Ltd. Trading as rg+p

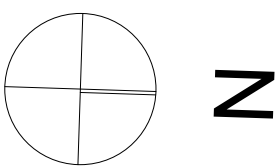



Floor Finish Key

- Floor - Novolon/Polyflor sheet vinyl
- Floor - Entrance area will be provided with dirt barrier, Gradus Boulevard 1500 or similar type entrance matting 1.2 m deep, colour from standard range available. Remaining floor area contract carpet tiles.
- Floor - Contract carpet tiles. Manufacturer: CFS Illusion or CFS VT480, or acceptable equivalent. To staircases provide contract carpet tiles. Gradus aluminium nosing's to all treads in contrasting colour.
- Plant rooms Floor - Watco paint finish



Project: Bletchley View South
100-331

Status: CONSTRUCTION

Client: Winvic Construction Ltd

Sheet title: Floor Finishes - Ground floor plan D

Scale: 1:50@A1

Date: 30/05/22


Drawn: SD

Checked: LD

Ref: E21062-RGP-D-00-DR-A-4700-C02

London | Birmingham | Leicester
0203 327 0381 | 0121 309 0071 | 0116 204 5800
rg-p.co.uk · design@rg-p.co.uk

Notes
All designs should be constructed in strict accordance with building regulations.
In addition any materials, components and fixings in/or connected to a facade should be non-combustible if the top storey of the building is above 11m.
All dimensions to be checked on site. Do not scale off this drawing for construction purposes.
This drawing is the copyright of the Architect, and not to be reproduced without their permission.
Ordnance Survey map information reproduced with permission of HMSSD Crown Copyright reserved.
rg-p Ltd. Trading as rg-p

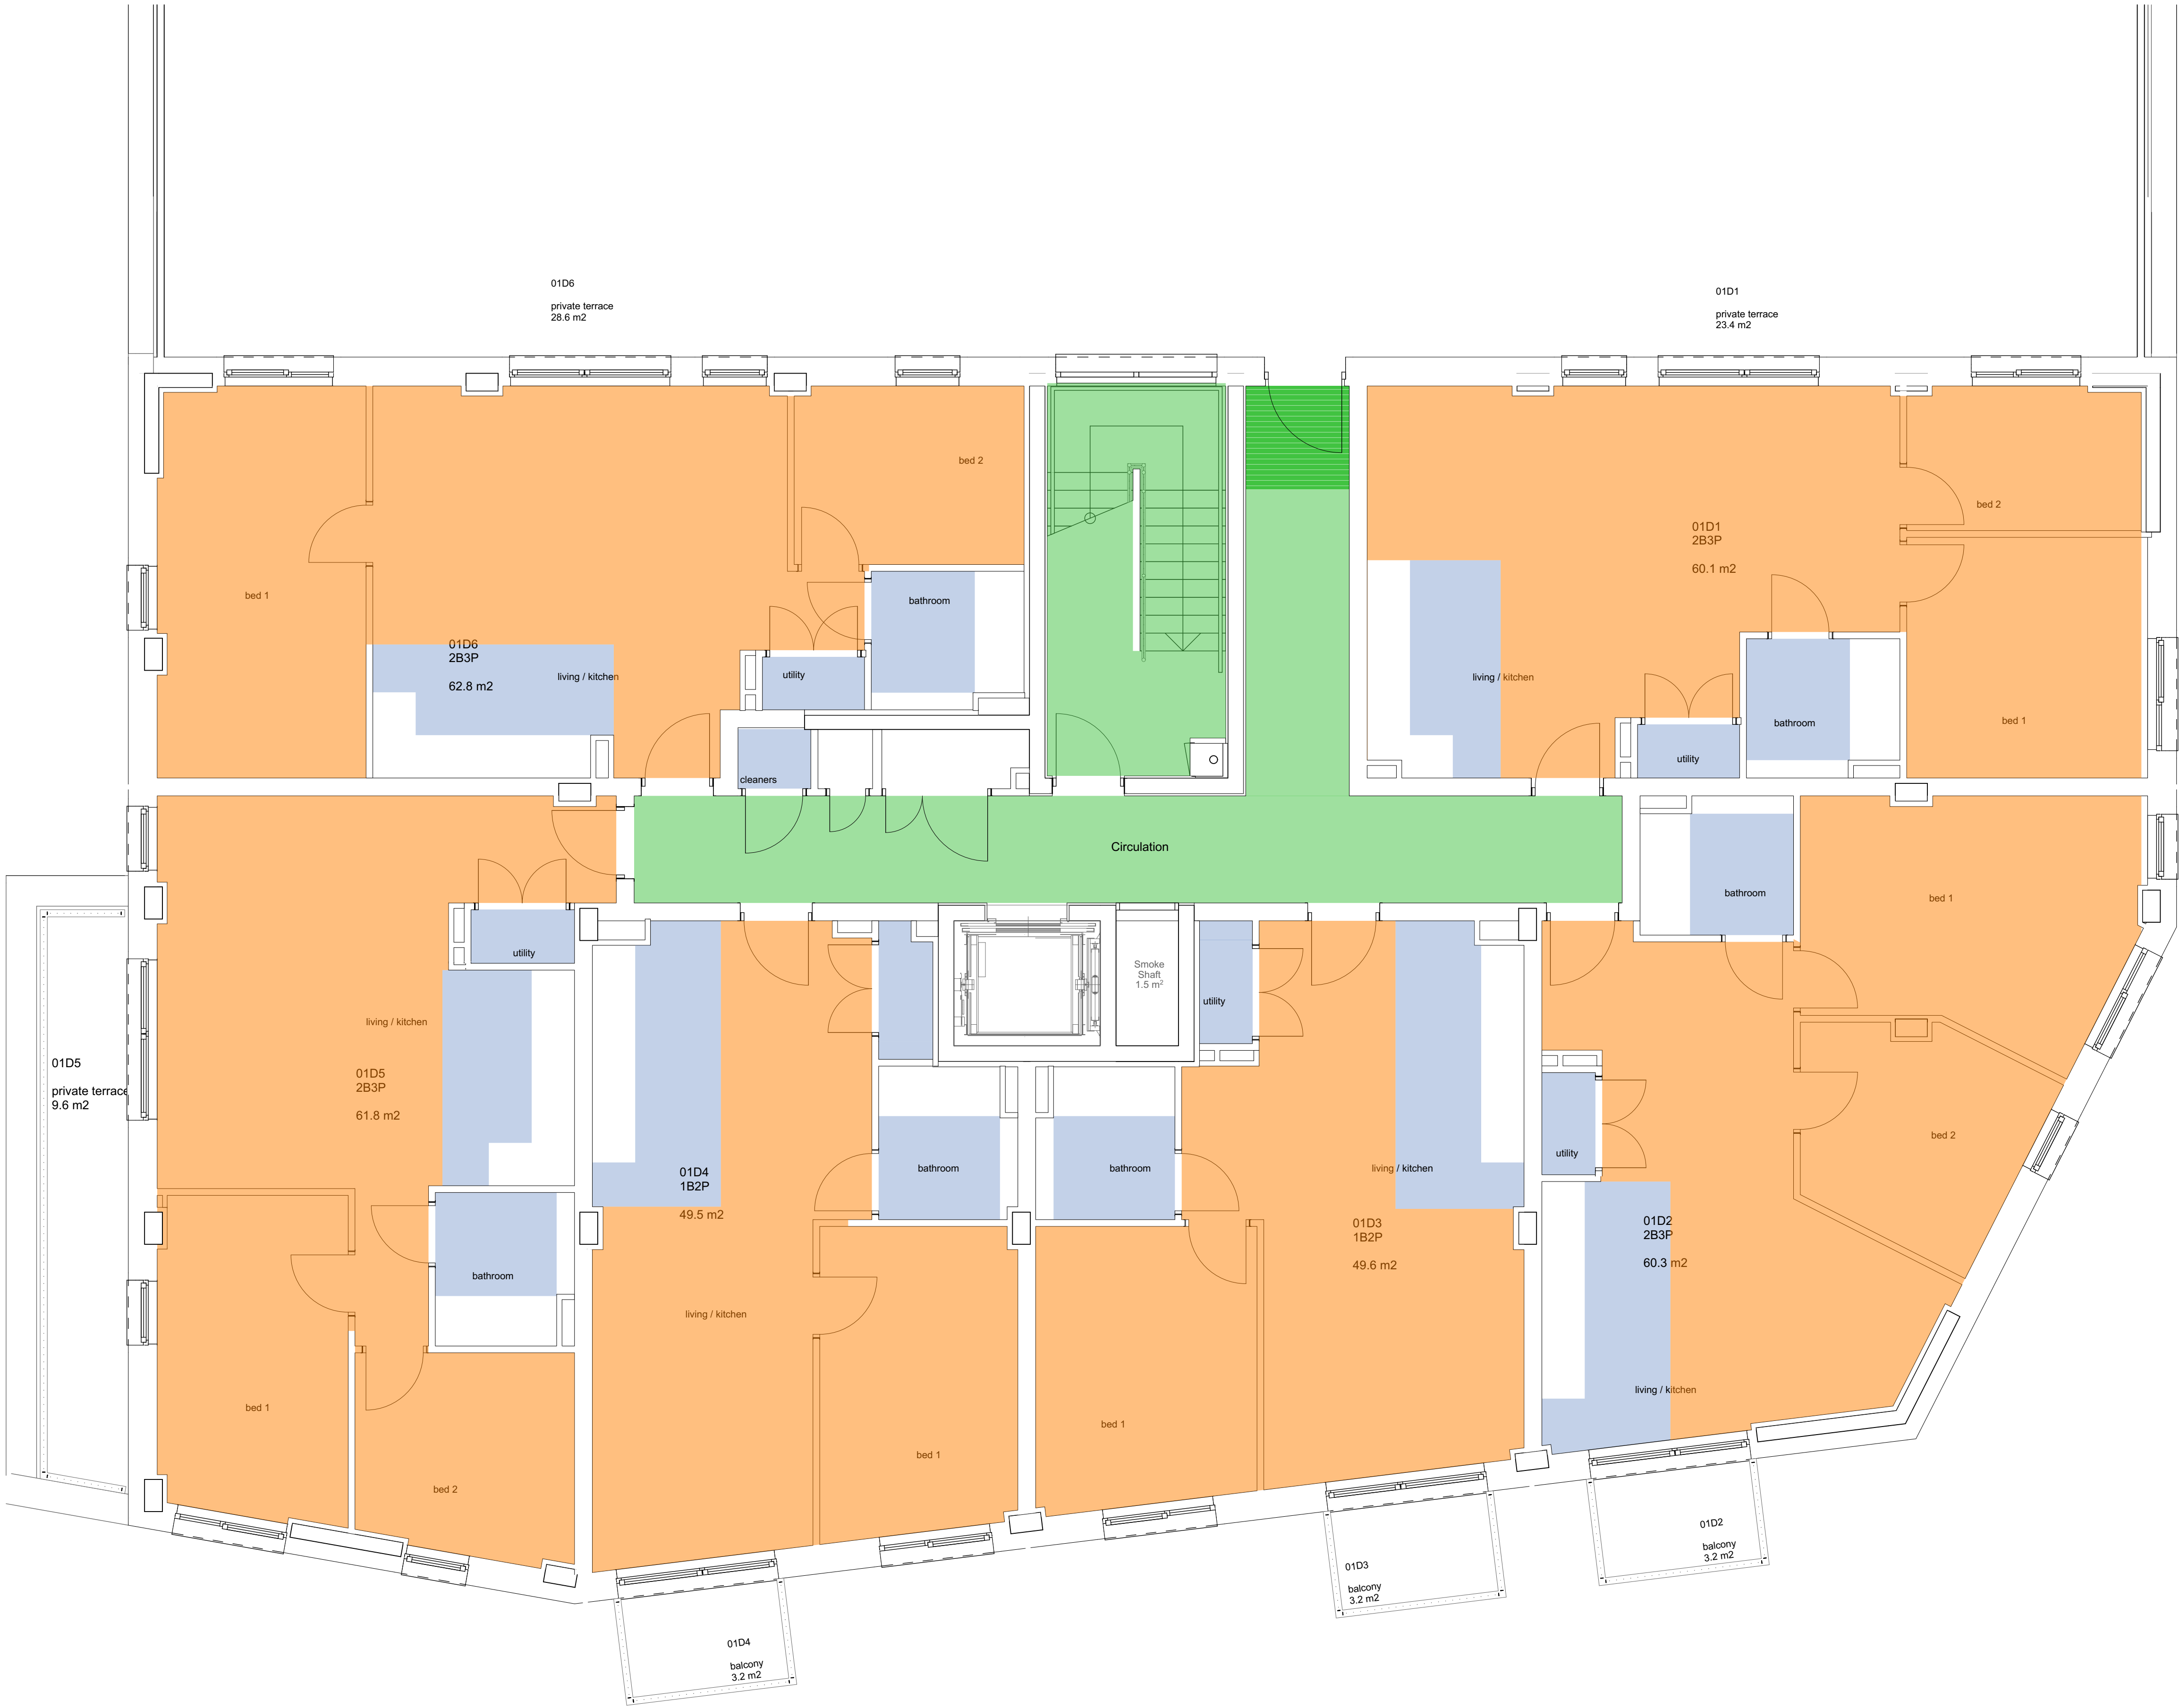

Floor Finish Key

- Floor - Novolon/Polyflor sheet vinyl
- Floor - Entrance area will be provided with dirt barrier, Gradus Boulevard 1500 or similar type entrance matting 1.2 m deep, colour from standard range available. Remaining floor area contract carpet tiles.
- Floor - Contract carpet tiles. Manufacturer: CFS Illusion or CFS VT480, or acceptable equivalent. To staircases provide contract carpet tiles. Gradus aluminium nosing's to all treads in contrasting colour.
- Plant rooms Floor - Watco paint finish
- UKF- Genius carpet



Project: Bletchley View South
100-331

Status: CONSTRUCTION

Client: Winvic Construction Ltd

Sheet title: Floor Finishes - First floor plan D

Scale: 1:50@A1

Date: 30/05/22

Drawn: SD

Checked: LD

Ref: E21062-RGP-D-01-DR-A-4701-C02

London | Birmingham | Leicester
0203 327 0381 | 0121 309 0071 | 0116 204 5800
rg-p.co.uk - design@rg-p.co.uk

Notes
All designs should be constructed in strict accordance with building regulations.
In addition any materials, components and fixings in/vor connected to a façade should be non-combustible if the top storey of the building is above 11m.
All dimensions to be checked on site. Do not scale off this drawing for construction purposes.
This drawing is the copyright of the Architect, and not to be reproduced without their permission.
Ordnance Survey map information reproduced with permission of HMSSD Crown Copyright reserved.
rg-p Ltd. Trading as rg-p



Floor Finish Key

- Floor - Novolon/Polyflor sheet vinyl
- Floor - Entrance area will be provided with dirt barrier, Gradus Boulevard 1500 or similar type entrance matting 1.2 m deep, colour from standard range available. Remaining floor area contract carpet tiles.
- Floor - Contract carpet tiles. Manufacturer: CFS Illusion or CFS VT480, or acceptable equivalent. To staircases provide contract carpet tiles. Gradus aluminium nosing's to all treads in contrasting colour.
- Plant rooms Floor - Watco paint finish
- UKF- Genius carpet



Project: Bletchley View South
100-331
Status: CONSTRUCTION
Client: Winvic Construction Ltd

Sheet title: Floor Finishes - Second-Seventh Floor plan D

Scale: 1:50@A1

Date: 30/05/22


Drawn: SD


Checked: LD

Ref: E21062-RGP-D-SL-DR-A-4702-C02

London | Birmingham | Leicester
0203 327 0381 | 0121 309 0071 | 0116 204 5800
rg-p.co.uk · design@rg-p.co.uk

Notes
All designs should be constructed in strict accordance with building regulations.
In addition any materials, components and fixings in/via connected to a facade should be non-combustible if the top storey of the building is above 11m.
All dimensions to be checked on site. Do not scale off this drawing for construction purposes.
This drawing is the copyright of the Architect, and not to be reproduced without their permission.
Ordnance Survey map information reproduced with permission of HMSSD Crown Copyright reserved.
rg-p Ltd. Trading as rg-p

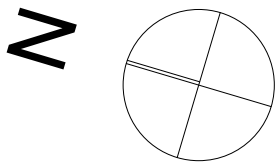

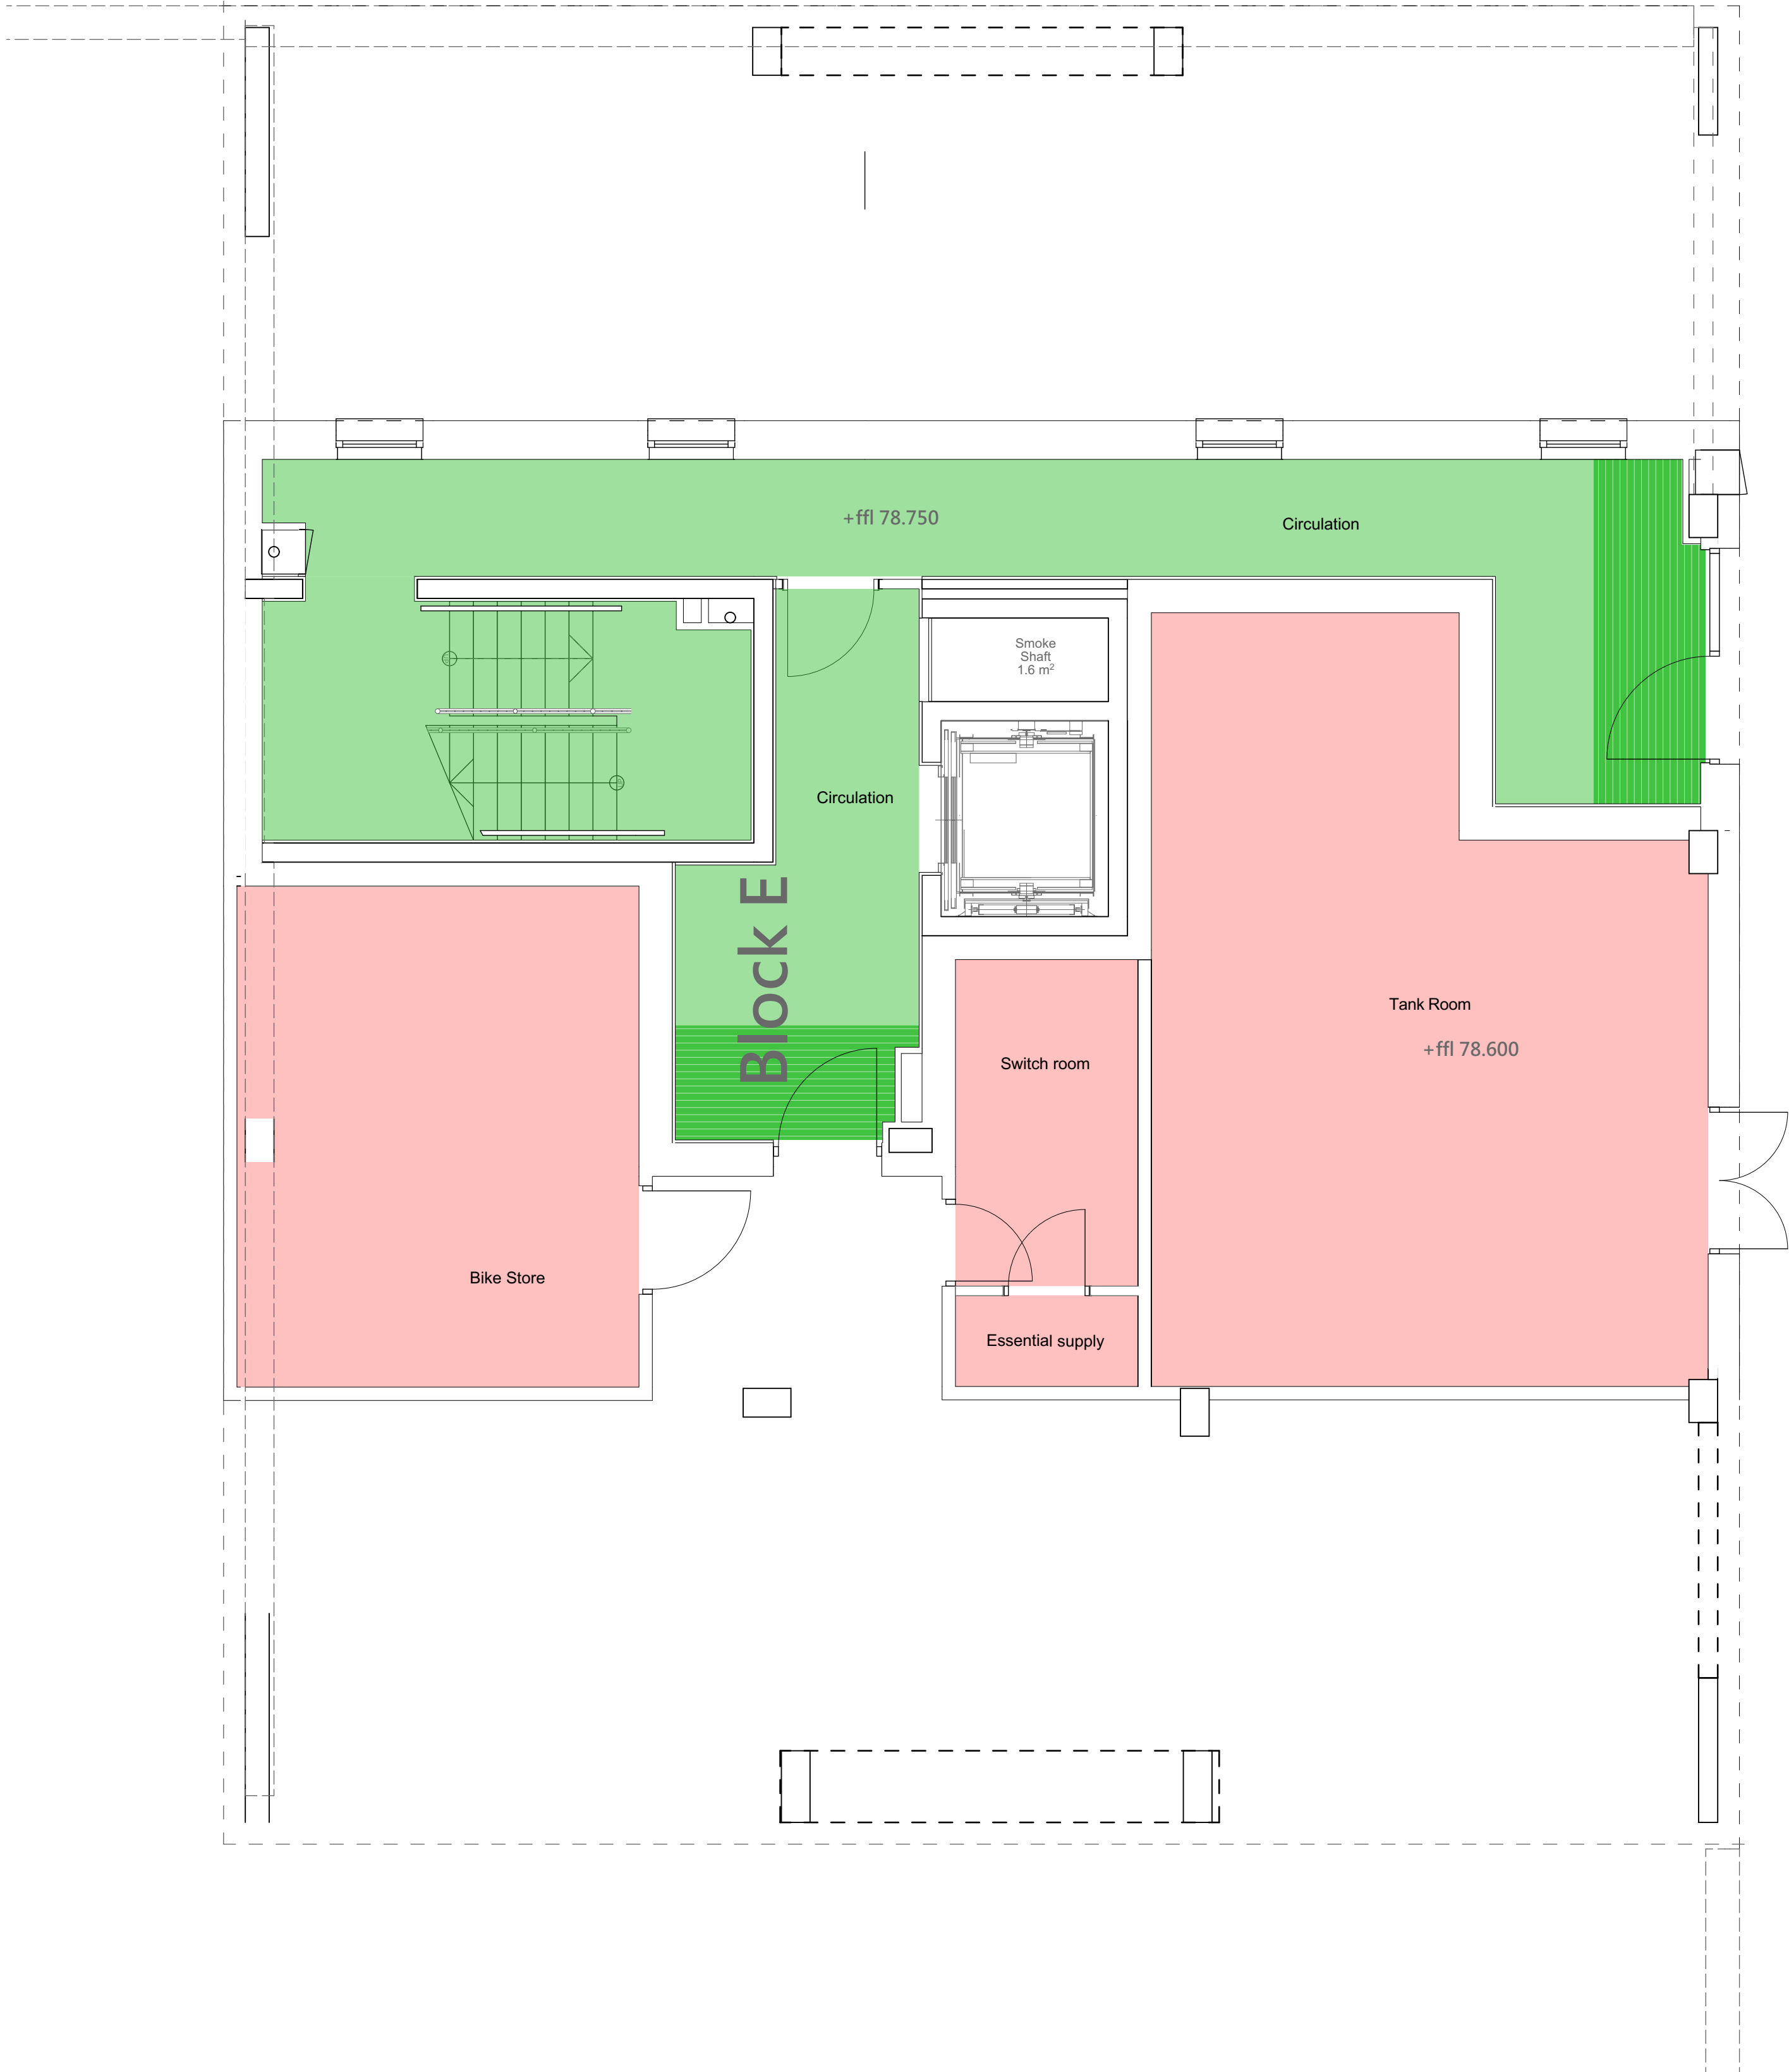

Floor Finish Key

Floor - Novolon/Polyflor sheet vinyl

Floor - Entrance area will be provided with dirt barrier, Gradus Boulevard 1500 or similar type entrance matting 1.2 m deep, colour from standard range available. Remaining floor area contract carpet tiles.

Floor - Contract carpet tiles. Manufacturer: CFS Illusion or CFS VT480, or acceptable equivalent. To staircases provide contract carpet tiles. Gradus aluminium nosing's to all treads in contrasting colour.

Plant rooms Floor - Watco paint finish



Project:	Bletchley View South 100-331
Status:	CONSTRUCTION
Client:	Winvic Construction Ltd
Sheet title:	Floor Finishes - Ground floor plan E
Scale:	1:50@A1
Date:	December 2022
Drawn:	LD
Checked:	SD
Ref:	E21062-RGP-E-00-DR-A-5700-C01

Revision:	Date:	Drawn:	Check:
C01 Construction issue	21/12/22	LD	SD
C02 Floor Finish Updated according to Clients Comments, issued on 25th Jan.	13/02/23	NKZ	THR



Floor Finish Key

- Floor - Novolon/Polyflor sheet vinyl
- Floor - Entrance area will be provided with dirt barrier, Gradus Boulevard 1500 or similar type entrance matting 1.2 m deep, colour from standard range available. Remaining floor area contract carpet tiles.
- Floor - Contract carpet tiles. Manufacturer: CFS Illusion or CFS VT480, or acceptable equivalent. To staircases provide contract carpet tiles. Gradus aluminium nosing's to all treads in contrasting colour.
- Plant rooms Floor - Watco paint finish
- UKF- Genius carpet




Project:	Bletchley View South 100-331
Status:	CONSTRUCTION
Client:	Winvic Construction Ltd
Sheet title:	Floor Finishes - First floor plan E
Scale:	1:50@A1
Date:	December 2022
Drawn:	LD
Checked:	SD


Ref: E21062-RGP-E-01-DR-A-5701-C02

London | Birmingham | Leicester
0203 327 0381 | 0121 309 0071 | 0116 204 5800
rg-p.co.uk · design@rg-p.co.uk

Notes
All designs should be constructed in strict accordance with building regulations.
In addition any materials, components and fixings in/vor connected to a façade should be non-combustible if the top storey of the building is above 11m.
This drawing is the copyright of the Architect, and not to be reproduced without their permission.
Ordnance Survey map information reproduced with permission of HMSSO Crown Copyright reserved.
rg-p Ltd. Trading as rg+p

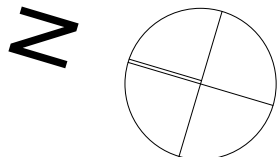

Revision:	Date:	Drawn:	Check:
C01 Construction issue	21/12/22	LD	SD
C02 Floor Finish Updated according to Clients Comments, issued on 25th Jan.	13/02/23	NKZ	THR

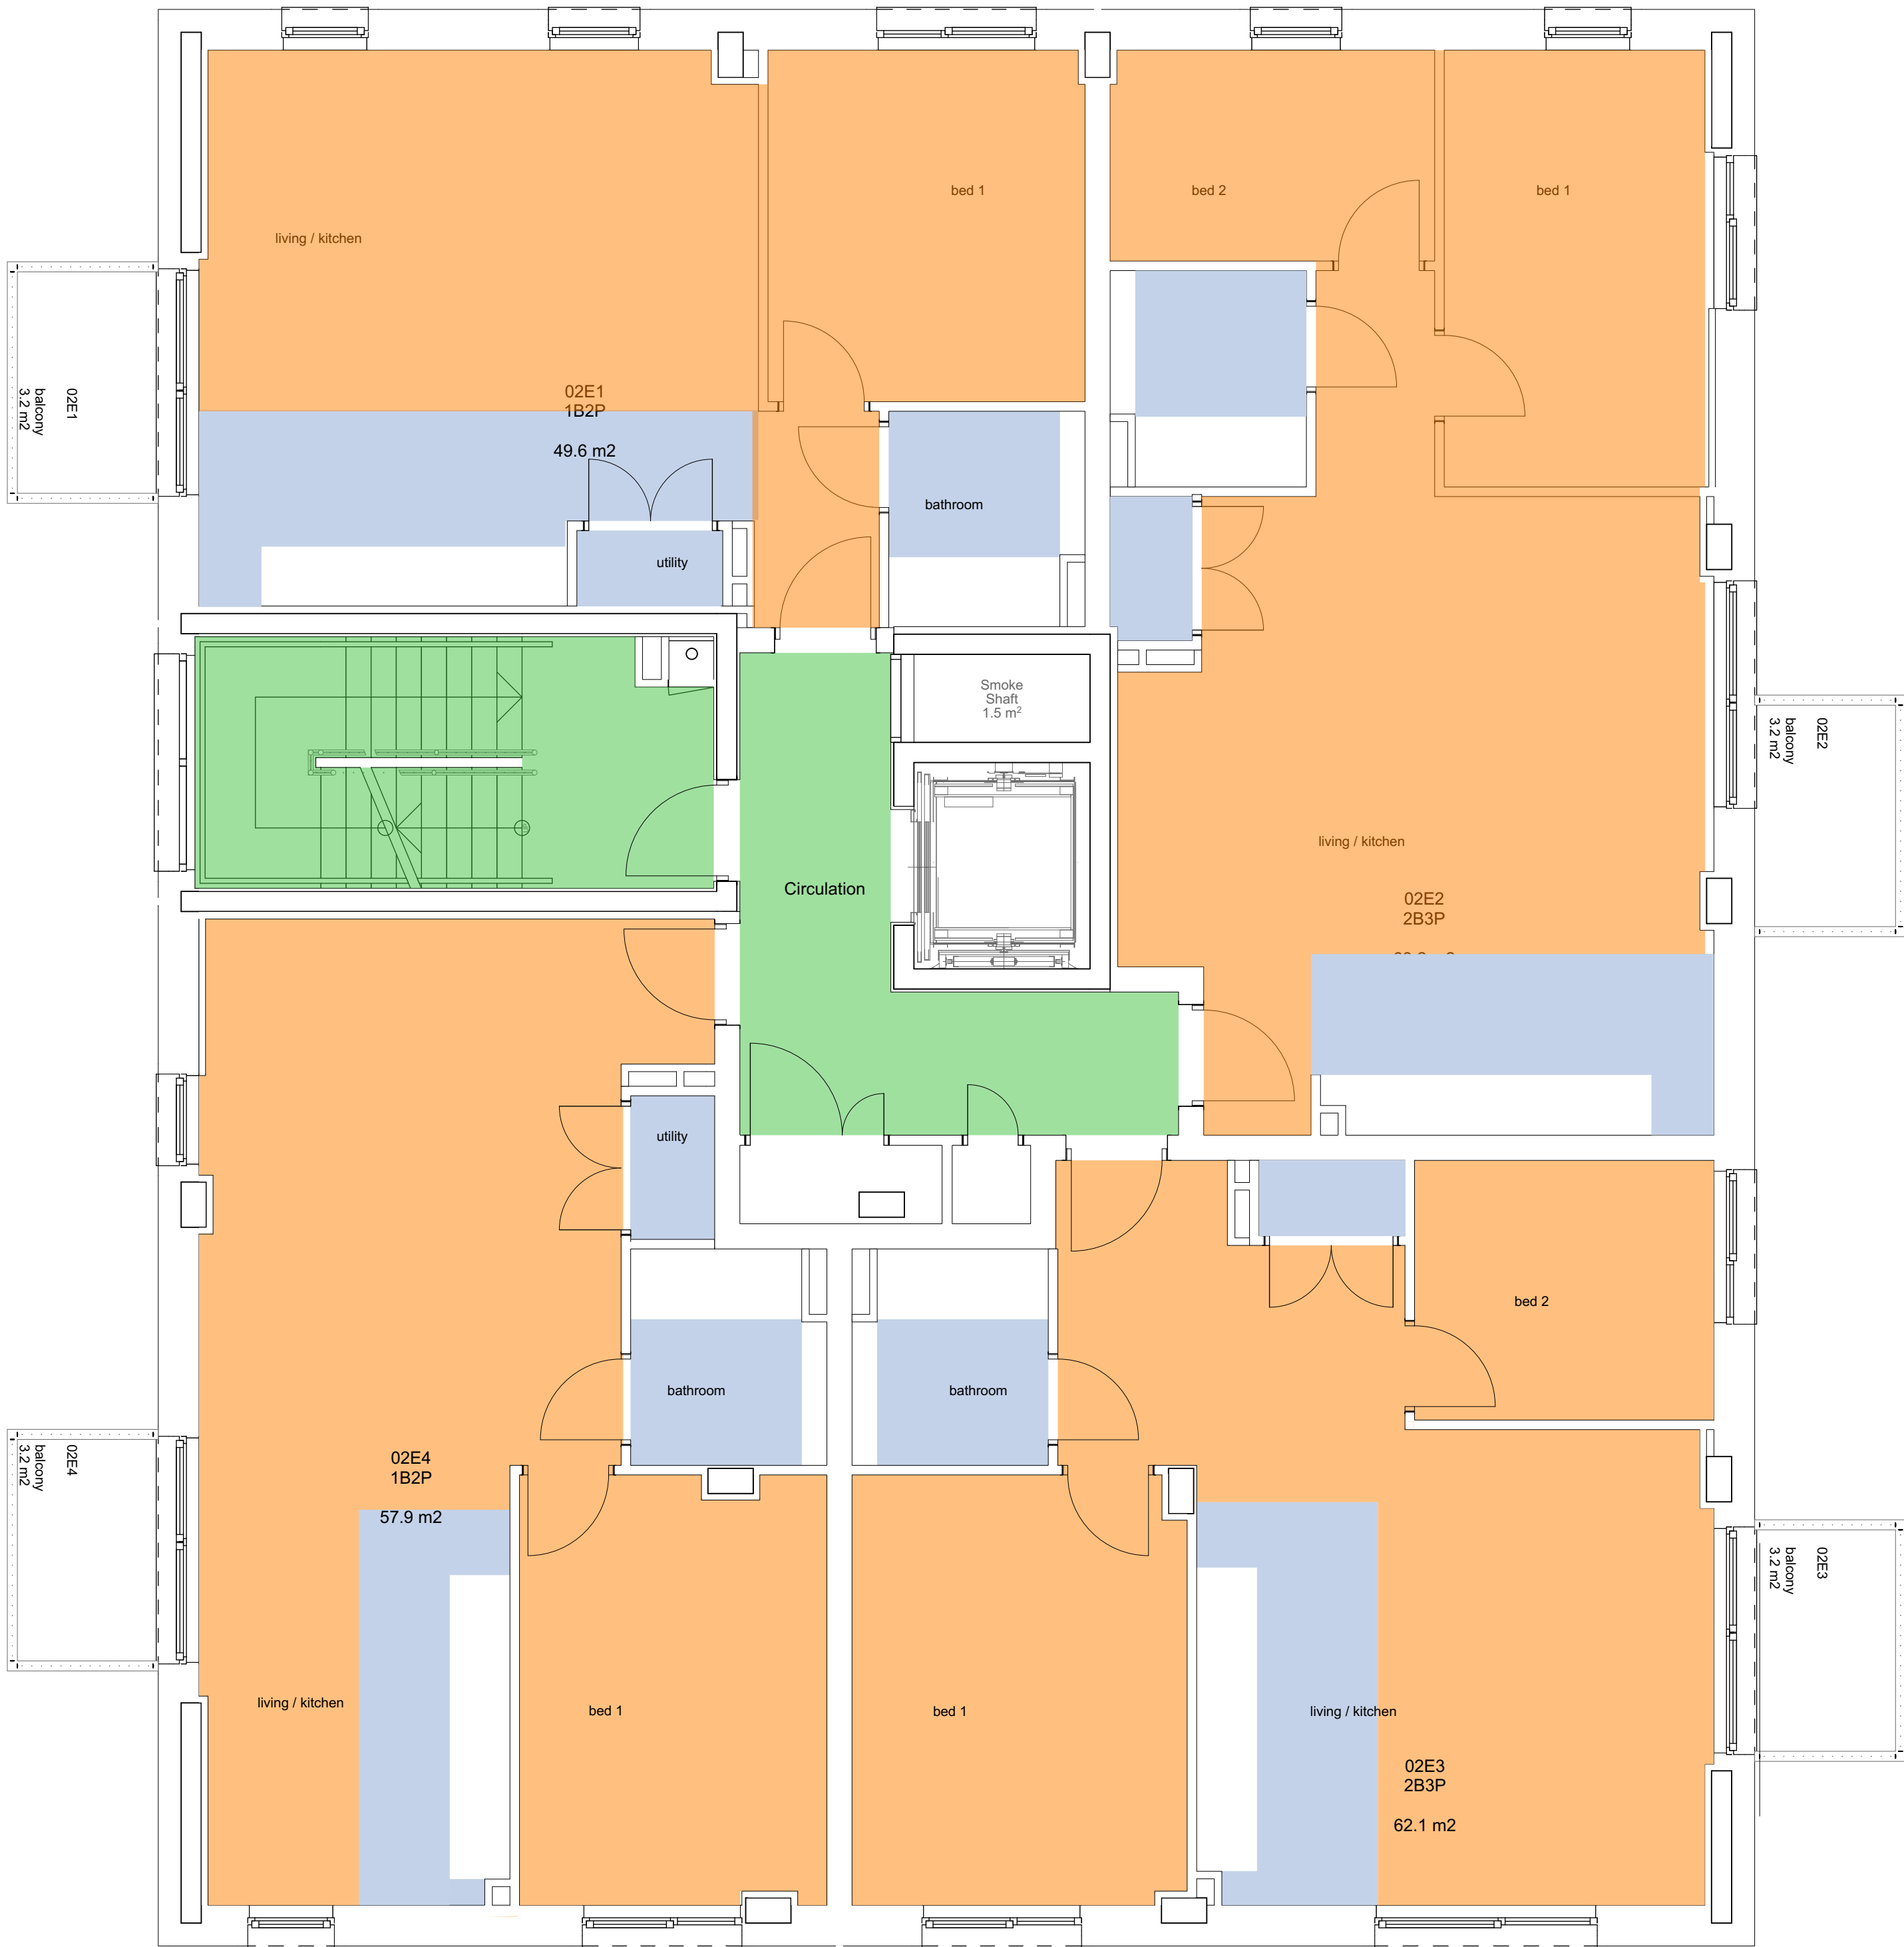

Floor Finish Key	
	Floor - Novolon/Polyflor sheet vinyl
	Floor - Entrance area will be provided with dirt barrier, Gradus Boulevard 1500 or similar type entrance matting 1.2 m deep, colour from standard range available. Remaining floor area contract carpet tiles.
	Floor - Contract carpet tiles. Manufacturer: CFS Illusion or CFS VT480, or acceptable equivalent. To staircases provide contract carpet tiles. Gradus aluminium nosing's to all treads in contrasting colour.
	Plant rooms Floor - Watco paint finish
	UKF- Genius carpet




Project:	Bletchley View South 100-331
Status:	CONSTRUCTION
Client:	Winvic Construction Ltd
Sheet title:	Floor Finishes - 2nd to 4th floor plan E
Scale:	1:50@A1
Date:	December 2022
Drawn:	LD
Checked:	SD
Ref:	E21062-RGP-E-SL-DR-A-5702-C02

London | Birmingham | Leicester
0203 327 0381 | 0121 309 0071 | 0116 204 5800
rg-p.co.uk · design@rg-p.co.uk

Notes
All designs should be constructed in strict accordance with building regulations.
In addition any materials, components and fixings in/or connected to a façade should be non-combustible if the top storey of the building is above 11m.
All dimensions to be checked on site. Do not scale off this drawing for construction purposes.
This drawing is the copyright of the Architect, and not to be reproduced without their permission.
Ordnance Survey map information reproduced with permission of HMSSD Crown Copyright reserved.
rg-p Ltd. Trading as rg-p

Revision:	Date:	Drawn:	Check:
C01 Construction issue	21/12/22	LD	SD
C02 Floor Finish Updated according to Clients Comments, issued on 25th Jan	13/02/23	NKZ	THR
C03 Updated to latest layout	17/05/23	LD	TH

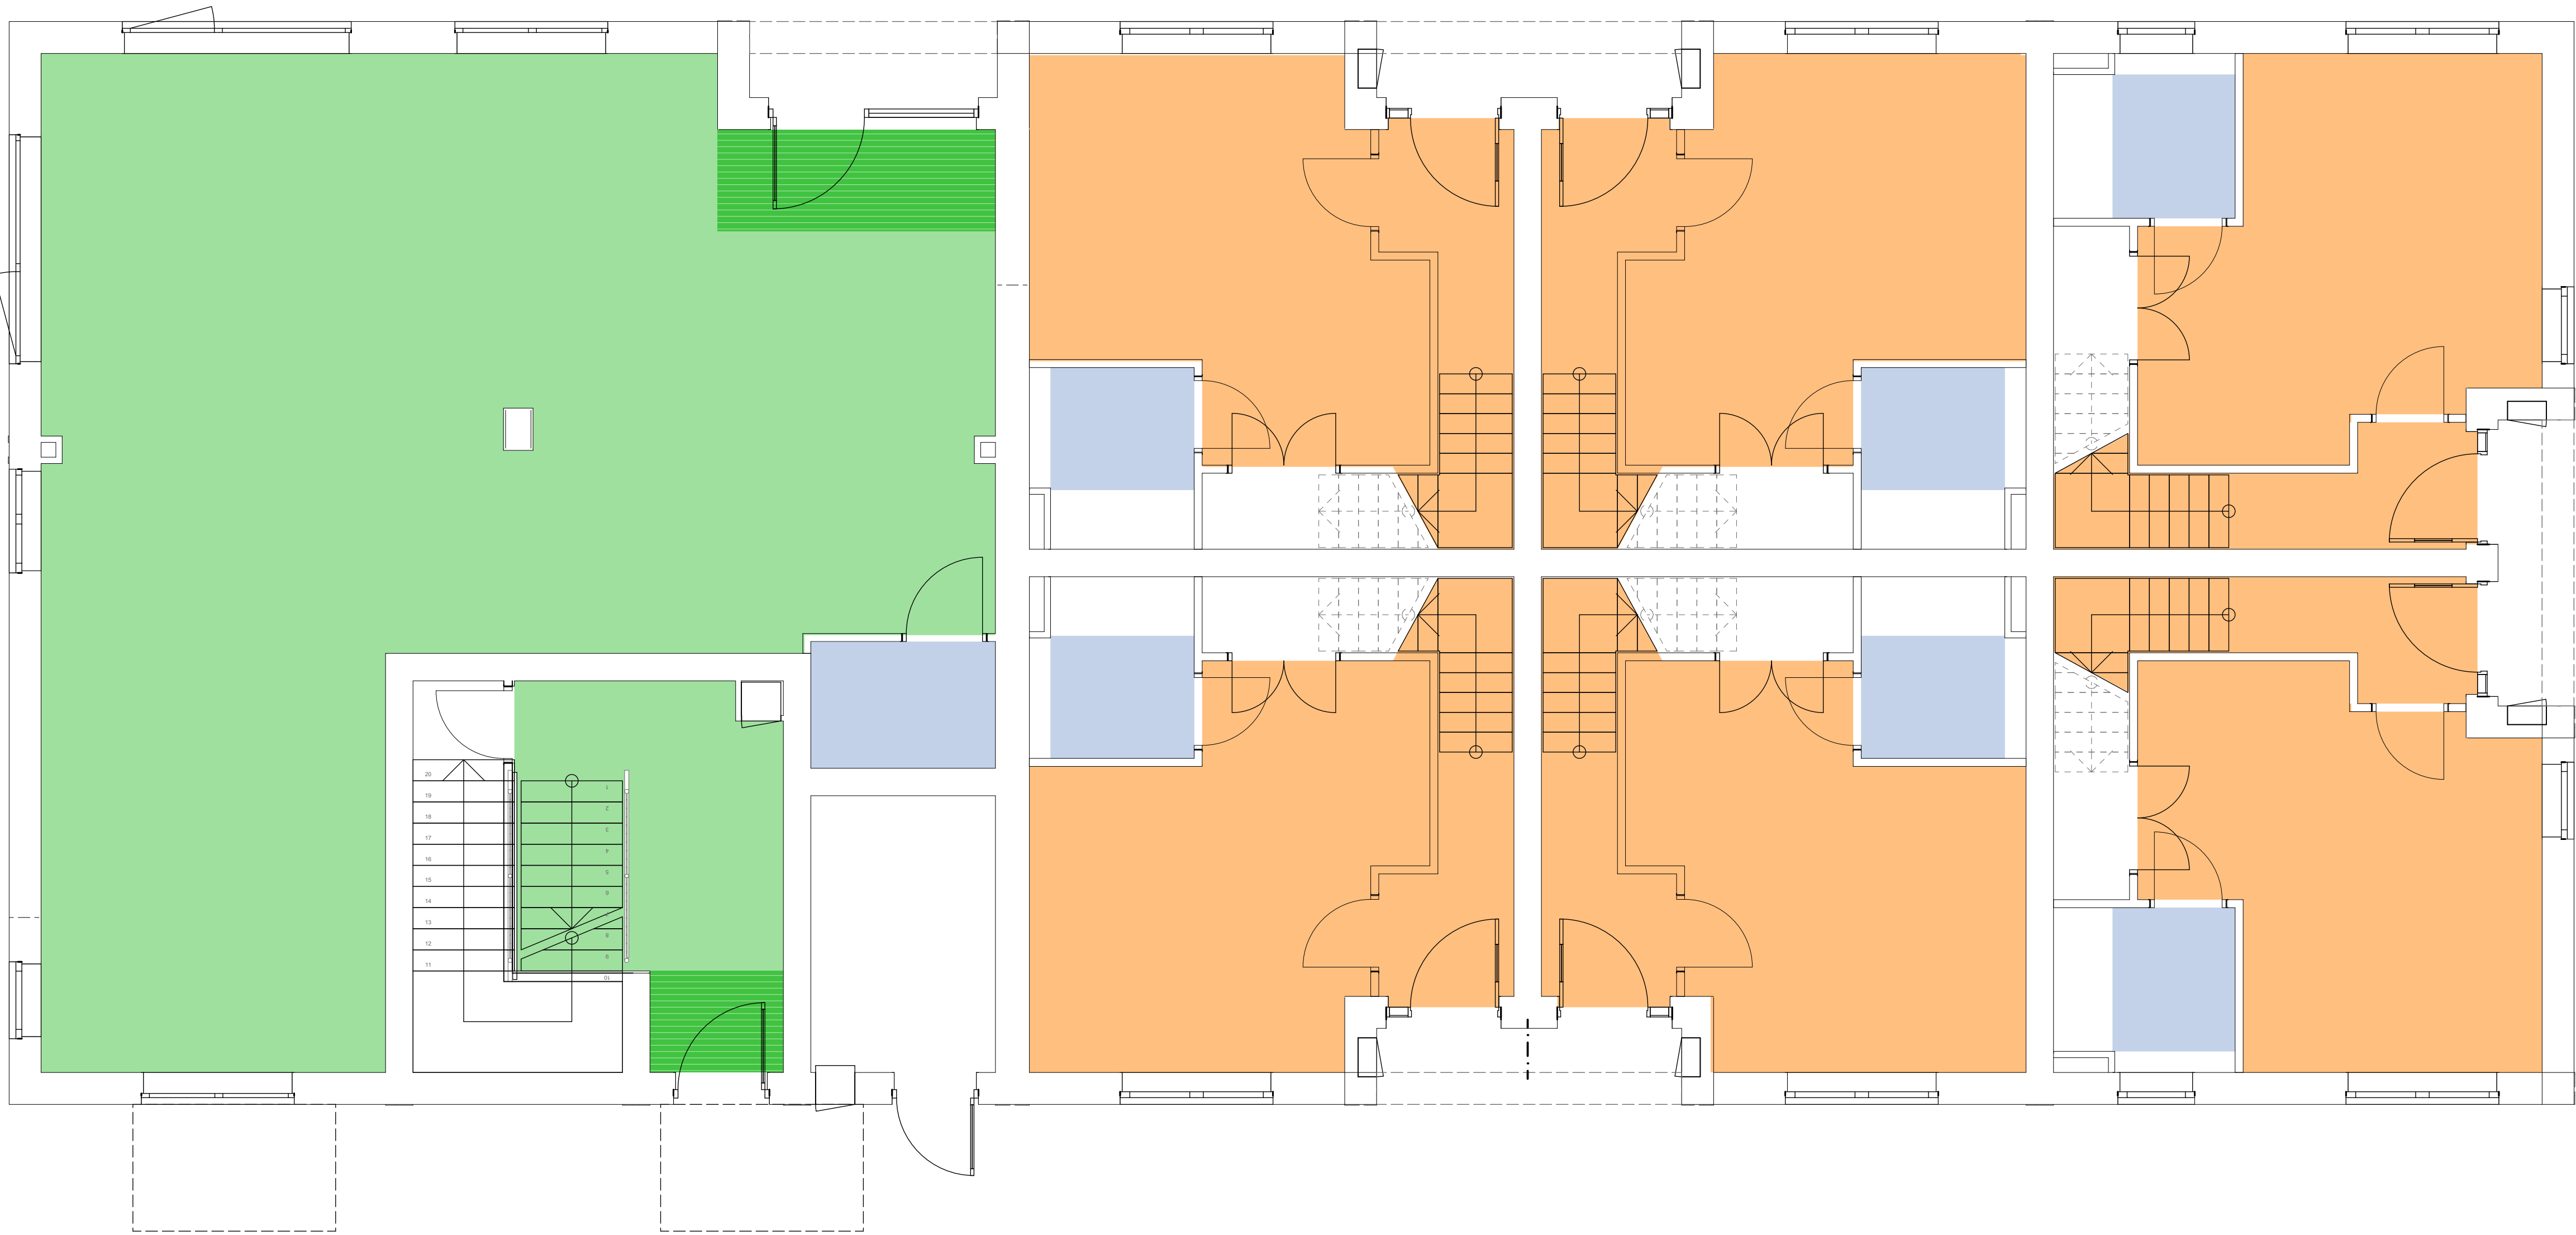

- Floor Finish Key**
- Floor - Novolon/Polyflor sheet vinyl
 - Floor - Entrance area will be provided with dirt barrier, Gradus Boulevard 1500 or similar type entrance matting 1.2 m deep, colour from standard range available. Remaining floor area contract carpet tiles.
 - Floor - Contract carpet tiles. Manufacturer: CFS Illusion or CFS VT480, or acceptable equivalent. To staircases provide contract carpet tiles. Gradus aluminium nosing's to all treads in contrasting colour.
 - Plant rooms Floor - Watco paint finish
 - UKF- Genius carpet




Project:	Bletchley View South 100-331
Status:	CONSTRUCTION
Client:	Winvic Construction Ltd
Sheet title:	Floor Finishes - Ground Floor Plan F
Scale:	1:50@A1
Date:	December 2022
Drawn:	LD
Checked:	THR
Ref:	E21062-RGP-F-00-DR-A-6700-C03

London | Birmingham | Leicester
0203 327 0381 | 0121 309 0071 | 0116 204 5800
rg-p.co.uk · design@rg-p.co.uk

Notes
All designs should be constructed in strict accordance with building regulations.
In addition any materials, components and fixings in/or connected to a façade should be non-combustible if the top storey of the building is above 11m.
All dimensions to be checked on site. Do not scale off this drawing for construction purposes.
This drawing is the copyright of the Architect, and not to be reproduced without their permission.
Ordnance Survey map information reproduced with permission of HMSSO Crown Copyright reserved.
rg-p Ltd. Trading as rg-p

Revision:	Date:	Drawn:	Check:
C01 Construction issue	21/12/22	LD	SD
C02 Floor Finish Updated according to Clients Comments, issued on 25th Jan.	13/02/23	NKZ	THR
C03 Updated to latest layout	17/05/23	LD	TH

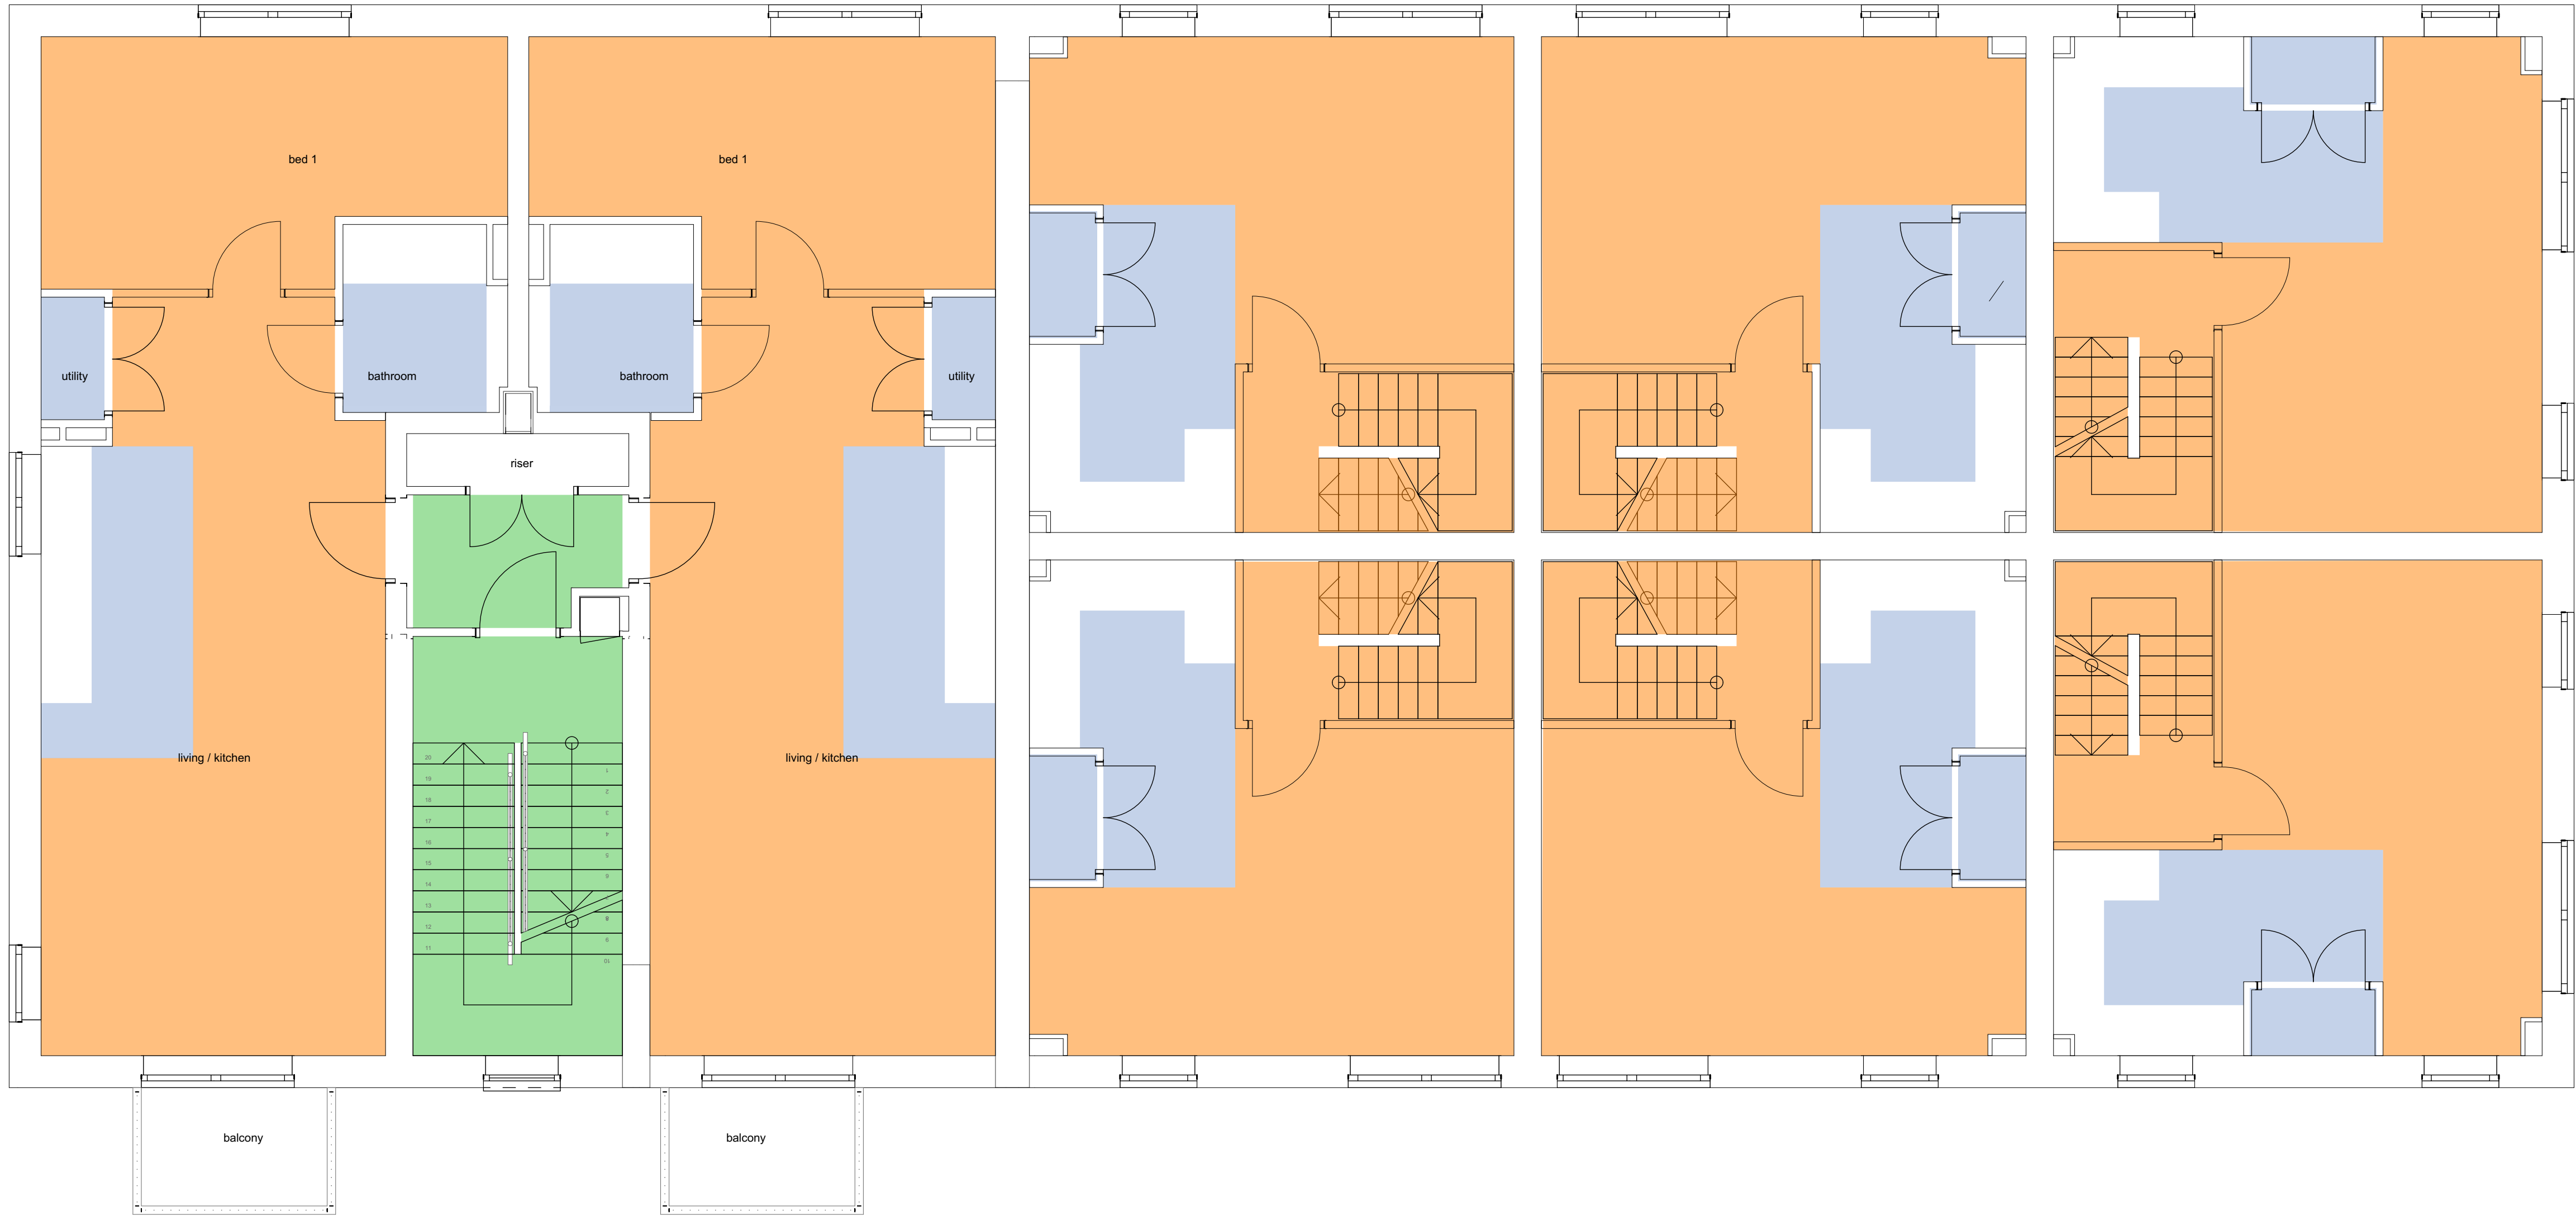

- Floor Finish Key**
- Floor - Novolon/Polyflor sheet vinyl
 - Floor - Entrance area will be provided with dirt barrier, Gradus Boulevard 1500 or similar type entrance matting 1.2 m deep, colour from standard range available. Remaining floor area contract carpet tiles.
 - Floor - Contract carpet tiles. Manufacturer: CFS Illusion or CFS VT480, or acceptable equivalent. To staircases provide contract carpet tiles. Gradus aluminium nosing's to all treads in contrasting colour.
 - Plant rooms Floor - Watco paint finish
 - UKF- Genius carpet




Project:	Bletchley View South 100-331
Status:	CONSTRUCTION
Client:	Winvic Construction Ltd
Sheet title:	Floor Finishes - First Floor Plan F
Scale:	1:50@A1
Date:	December 2022
Drawn:	LD
Checked:	THR
Ref:	E21062-RGP-F-01-DR-A-6701-C03

London | Birmingham | Leicester
0203 327 0381 | 0121 309 0071 | 0116 204 5800
rg-p.co.uk · design@rg-p.co.uk

Notes
All designs should be constructed in strict accordance with building regulations.
In addition any materials, components and fixings in/or connected to a façade should be non-combustible if the top storey of the building is above 11m.
All dimensions to be checked on site. Do not scale off this drawing for construction purposes.
This drawing is the copyright of the Architect, and not to be reproduced without their permission.
Ordnance Survey map information reproduced with permission of HMSSO Crown Copyright reserved.
rg-p Ltd. Trading as rg+p

Revision:	Date:	Drawn:	Check:
C01 Construction issue	21/12/22	LD	SD
C02 Floor Finish Updated according to Clients Comments, issued on 25th Jan.	13/02/23	NKZ	THR
C03 Updated to latest layout	17/05/23	LD	TH

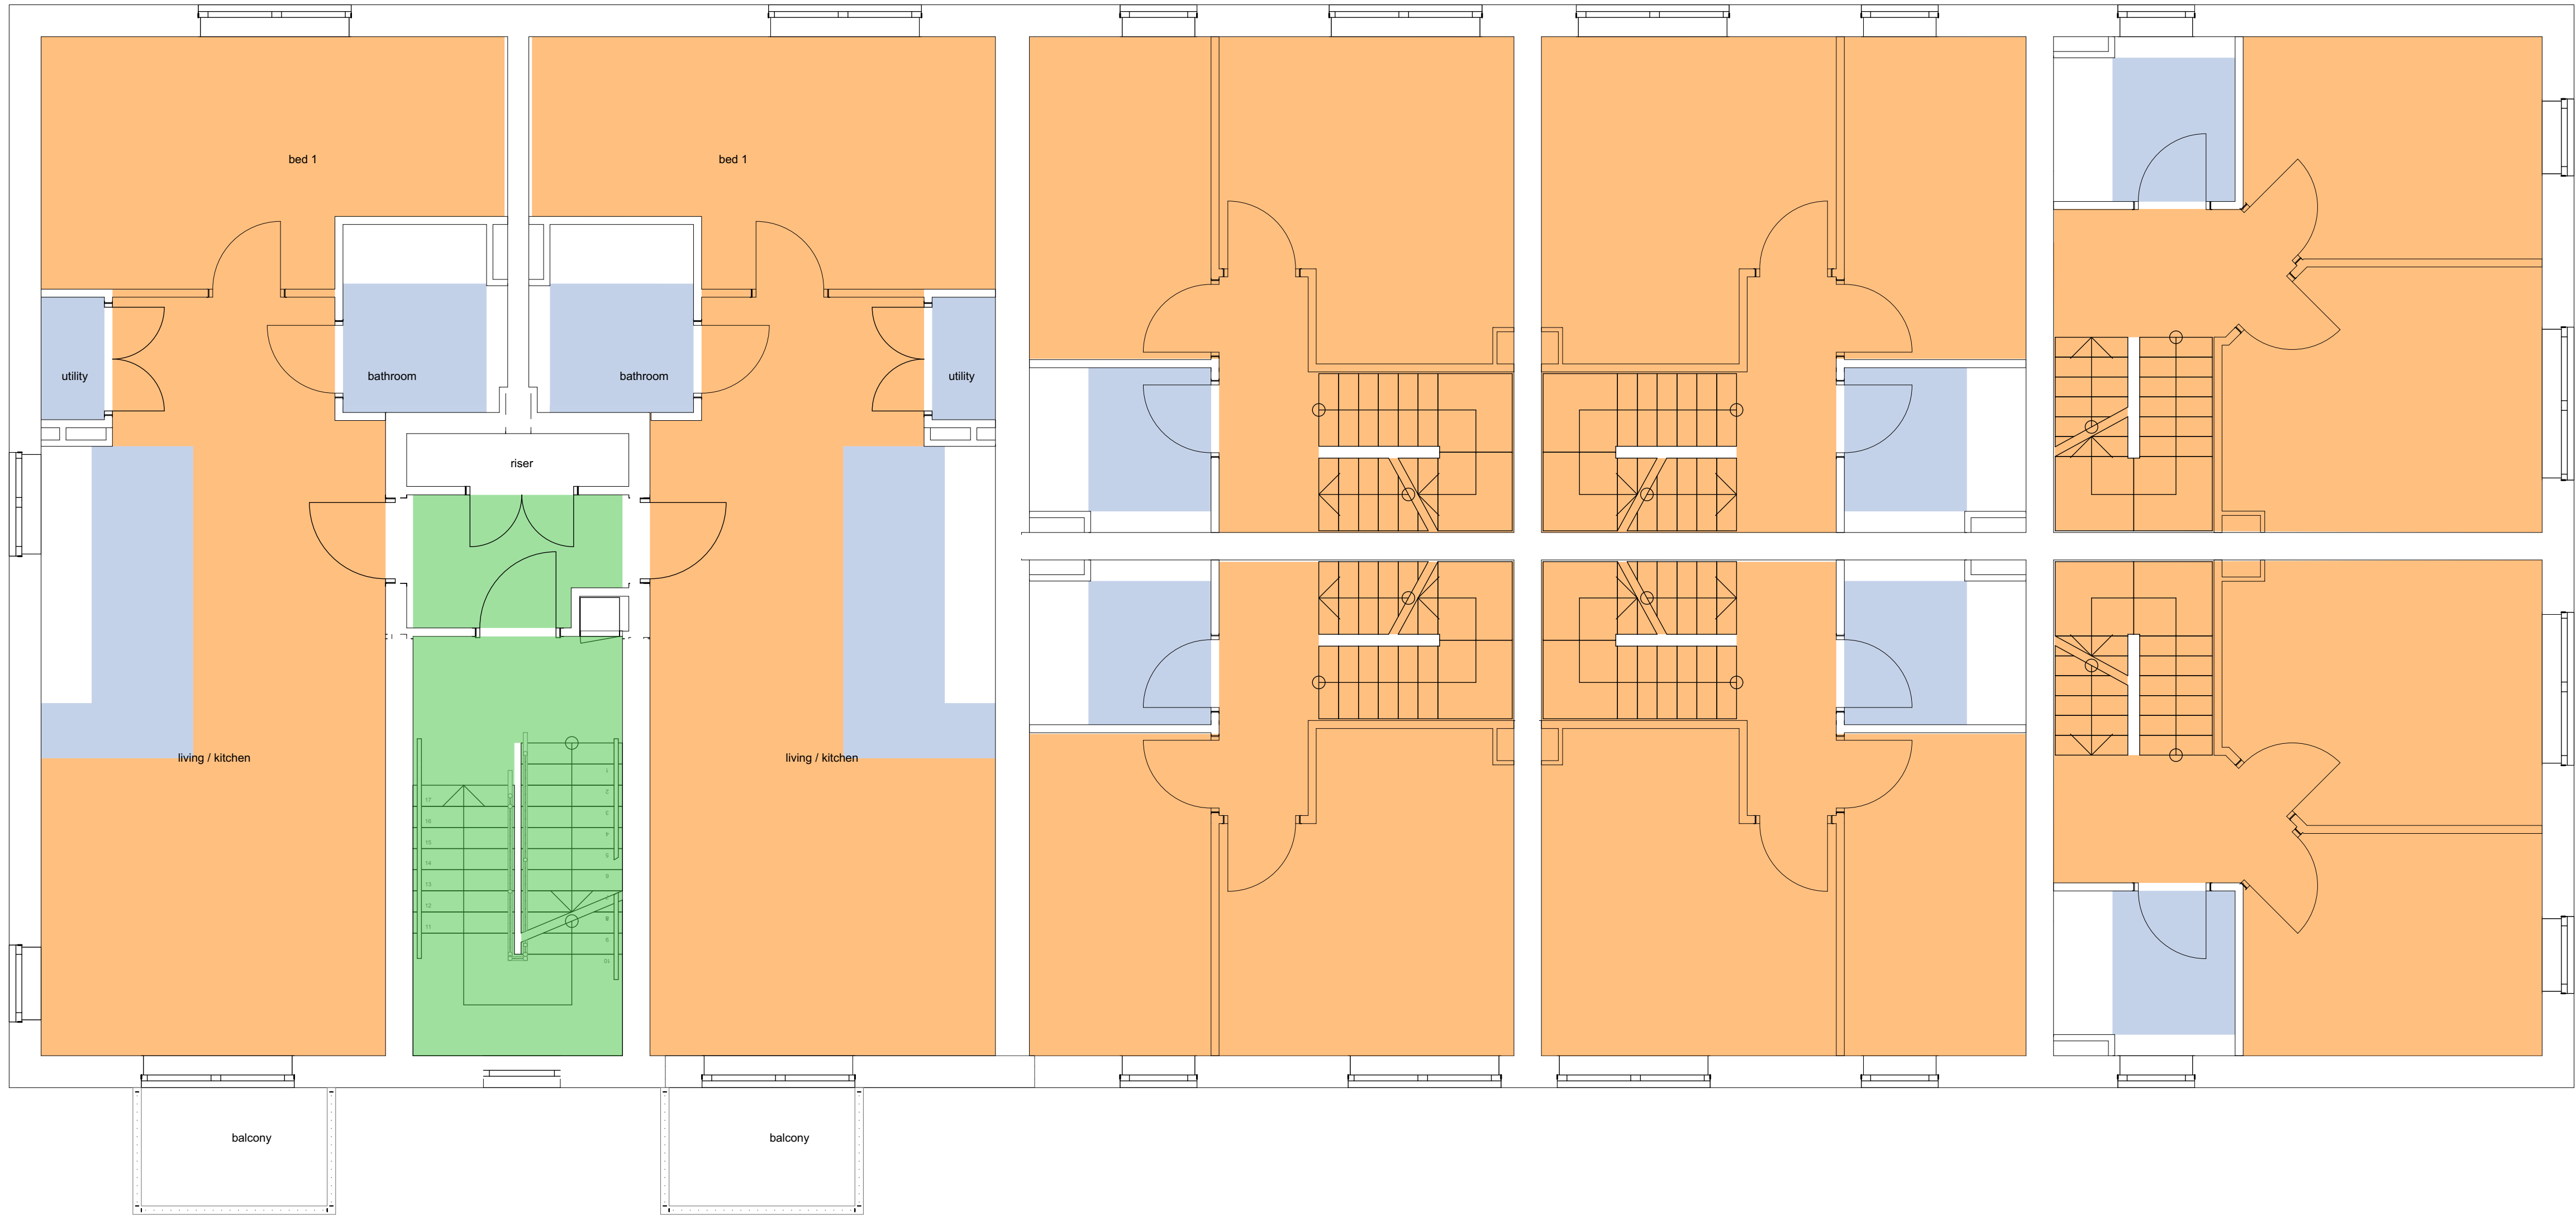


Floor Finish Key	
	Floor - Novolon/Polyflor sheet vinyl
	Floor - Entrance area will be provided with dirt barrier, Gradus Boulevard 1500 or similar type entrance matting 1.2 m deep, colour from standard range available. Remaining floor area contract carpet tiles.
	Floor - Contract carpet tiles. Manufacturer: CFS Illusion or CFS VT480, or acceptable equivalent. To staircases provide contract carpet tiles. Gradus aluminium nosing's to all treads in contrasting colour.
	Plant rooms Floor - Watco paint finish
	UKF- Genius carpet




Project:	Bletchley View South 100-331
Status:	CONSTRUCTION
Client:	Winvic Construction Ltd
Sheet title:	Floor Finishes - Second Floor Plan F
Scale:	1:50@A1
Date:	December 2022
Drawn:	LD
Checked:	THR
Ref:	E21062-RGP-F-02-DR-A-6702-C03

London | Birmingham | Leicester
0203 327 0381 | 0121 309 0071 | 0116 204 5800
rg-p.co.uk · design@rg-p.co.uk

Notes
All designs should be constructed in strict accordance with building regulations.
In addition any materials, components and fixings in/or connected to a facade should be non-combustible if the top storey of the building is above 11m.
All dimensions to be checked on site. Do not scale off this drawing for construction purposes.
This drawing is the copyright of the Architect, and not to be reproduced without their permission.
Ordnance Survey map information reproduced with permission of HM&SO Crown Copyright reserved.
rg-p Ltd. Trading as rg-p

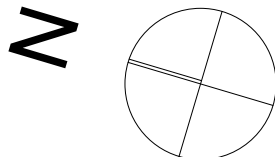

Revision:	Date:	Drawn:	Check:
C01	Construction issue	21/12/22	LD SD
C02	Floor Finish Updated according to Clients Comments, issued on 25th Jan.	13/02/23	NKZ THR
C03	Updated to latest layout	17/05/23	LD TH

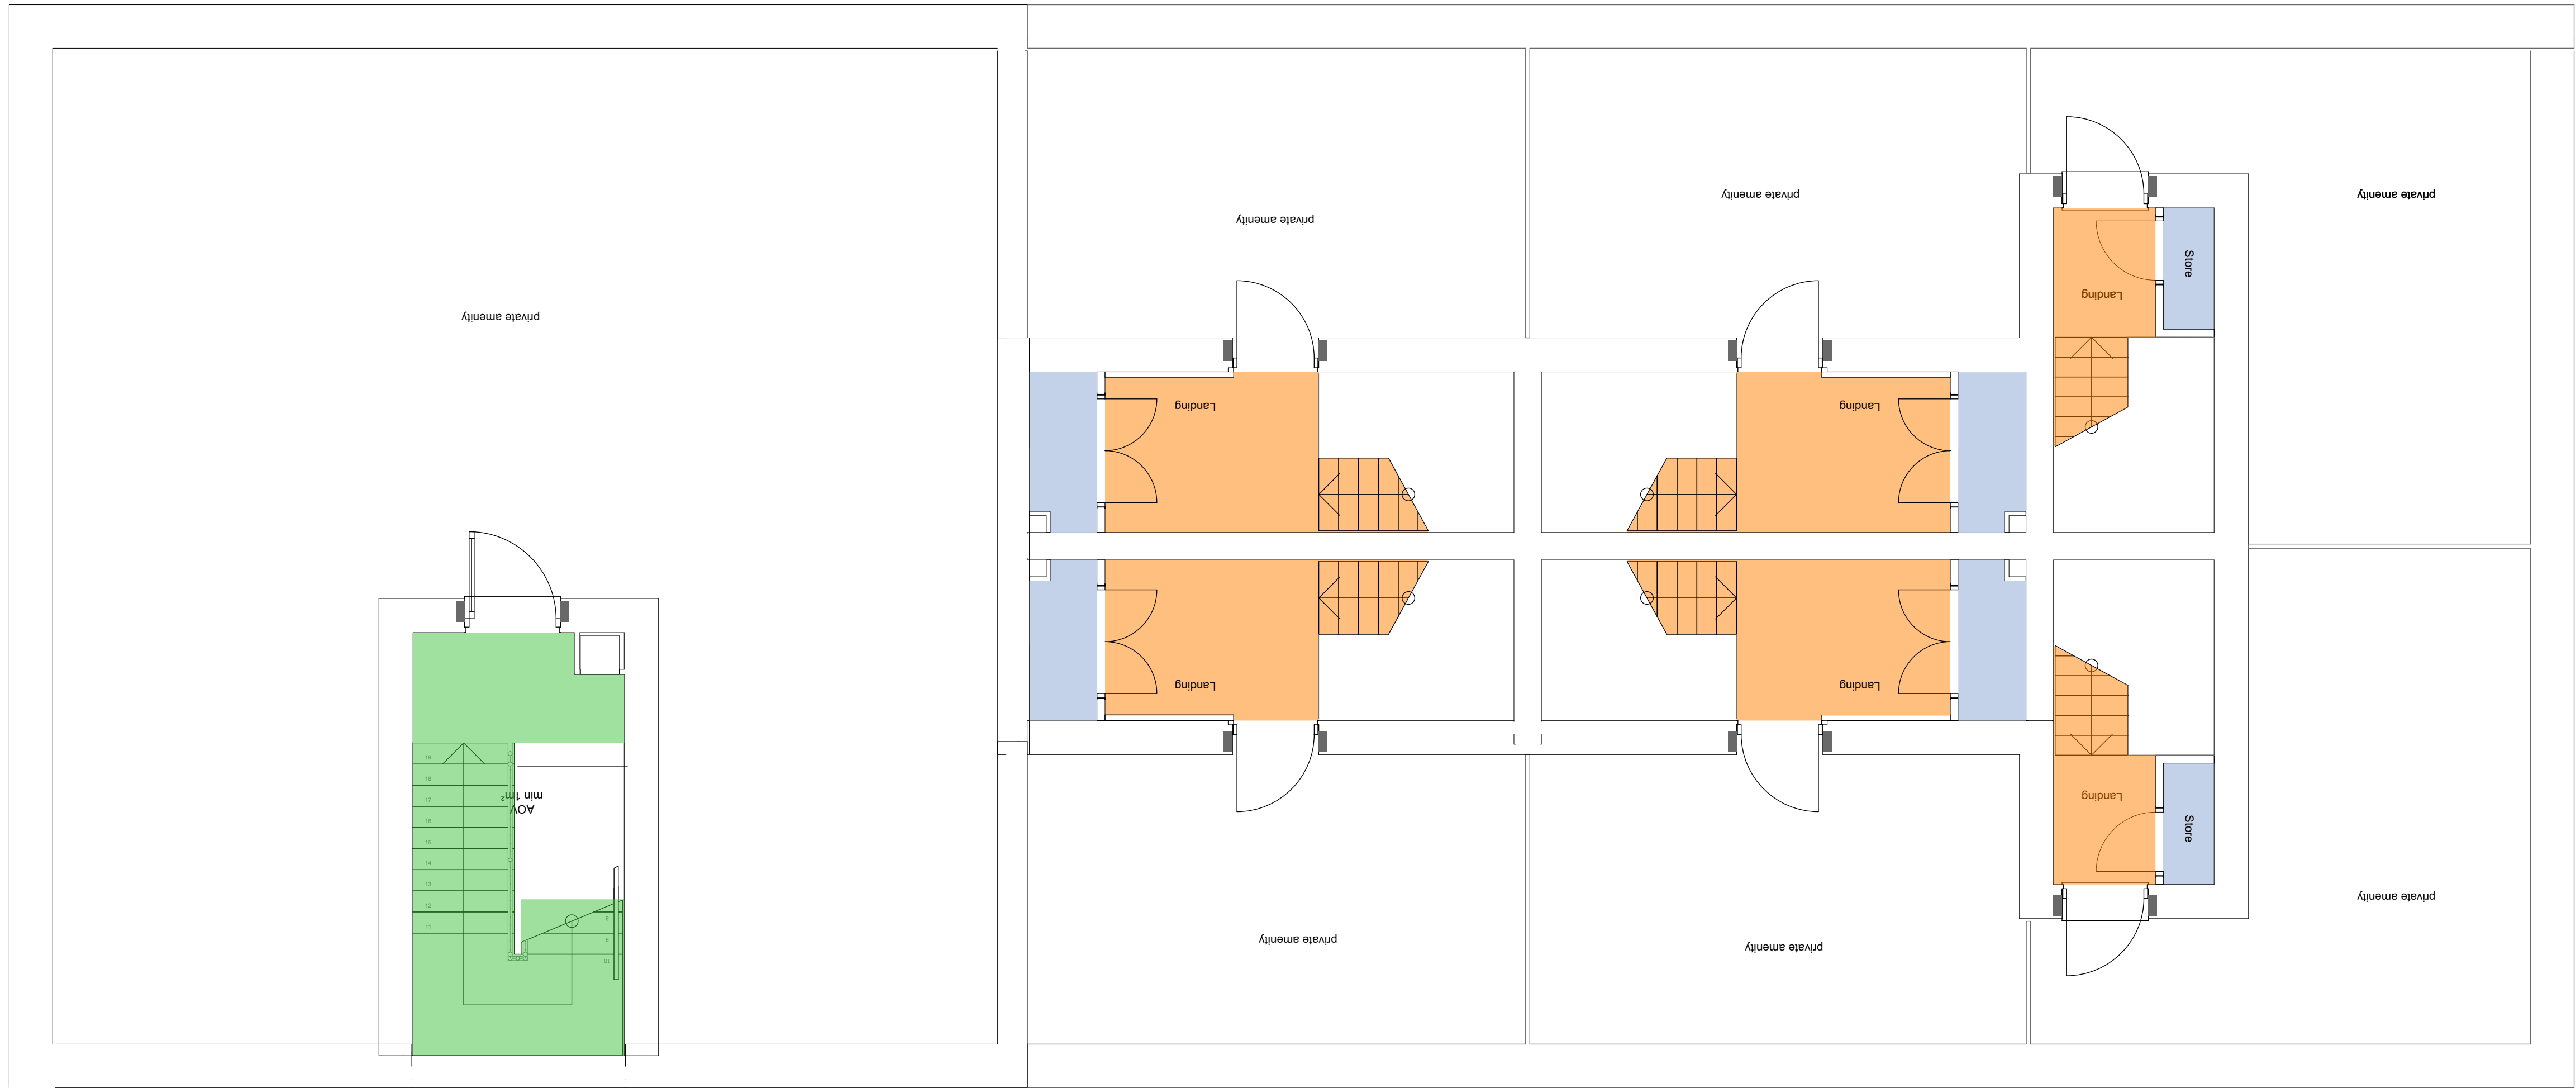

- Floor Finish Key**
- Floor - Novolon/Polyflor sheet vinyl
 - Floor - Entrance area will be provided with dirt barrier, Gradus Boulevard 1500 or similar type entrance matting 1.2 m deep, colour from standard range available. Remaining floor area contract carpet tiles.
 - Floor - Contract carpet tiles. Manufacturer: CFS Illusion or CFS VT480, or acceptable equivalent. To staircases provide contract carpet tiles. Gradus aluminium nosing's to all treads in contrasting colour.
 - Plant rooms Floor - Watco paint finish
 - UKF- Genius carpet



Project:	Bletchley View South 100-331
Status:	CONSTRUCTION
Client:	Winvic Construction Ltd
Sheet title:	Floor Finishes - Third floor plan F
Scale:	1:50@A1
Date:	December 2022
Drawn:	LD
Checked:	THR
Ref:	E21062-RGP-F-03-DR-A-6703-C03

London | Birmingham | Leicester
0203 327 0381 | 0121 309 0071 | 0116 204 5800
rg-p.co.uk · design@rg-p.co.uk

Notes
All designs should be constructed in strict accordance with building regulations.
In addition any materials, components and fixings in/or connected to a façade should be non-combustible if the top storey of the building is above 11m.
All dimensions to be checked on site. Do not scale off this drawing for construction purposes.
This drawing is the copyright of the Architect, and not to be reproduced without their permission.
Ordnance Survey map information reproduced with permission of HM&SO Crown Copyright reserved.
rg-p Ltd. Trading as rg+p